IREDELL COUNTY HEALTH DEPARTMENT

STATESVILLE 704-878-5305 MOORESVILLE 704-664-5281

IMPROVEMENT PERMIT / AUTHORIZATION TO CONSTRUCT / OPERATION PERMIT / EXISTING SYSTEM INSPECTION

PERMIT# 125320 PIN# 4639-61-5536.066 4639723141 DATE June 10, 05

OWNER OR CONTRACTOR Hyatt Prop. Inc. / Mark Gibson PHONE: Business Home

ADDRESS 885 N Hwy 16 Denver, N.C. 28037

LOCATION Perth Rd (N) TR Live Lane TR Bay Crossing Dr on right near end

SUBDIVISION Bay Crossing BLOCK / SECTION 2 LOT 66 LOT AREA .96ac SITE CLASS PS DESIGN FLOW 440gpd L.T.A.R. .3 unlimited / 1.25 Repair

Septic Tank: 1000 Gallons; STB 444 Date 2/27/06 ☒ New System ☐ Repair System Type: I, II, III, IV, V, VI

Pump Tank: 1000 Gallons; PT 27 Date 9/11/06 System Description: PM 25% Reduction

Pump Make: Gould's Model WE05P12H1 Serial No. Repair System Description: LPPPBPS

Nitrification Field: No Fields 1 Square Feet 1200 Linear Feet 400 Maintenance Agreement Required: ☐ Yes ☒ No initially

No Lines 5@80' Trench Width 36" Max Trench Bottom Depth 36" Gravel Depth NA

☒ House/Mod. Home No. Bedrooms 4 ☐ Mobile Home No. Bathrooms ☐ Business No. Employees ☐ Other


☐ Slab ☒ Crawl Space ☐ Basement w/plumbing ☐ Basement wo/plumbing

Water Supply: ☒ Individual ☐ Public ☐ Community


Comments:/Conditions:

Comments:/Conditions:

INITIAL SITE SKETCH 1"=50'

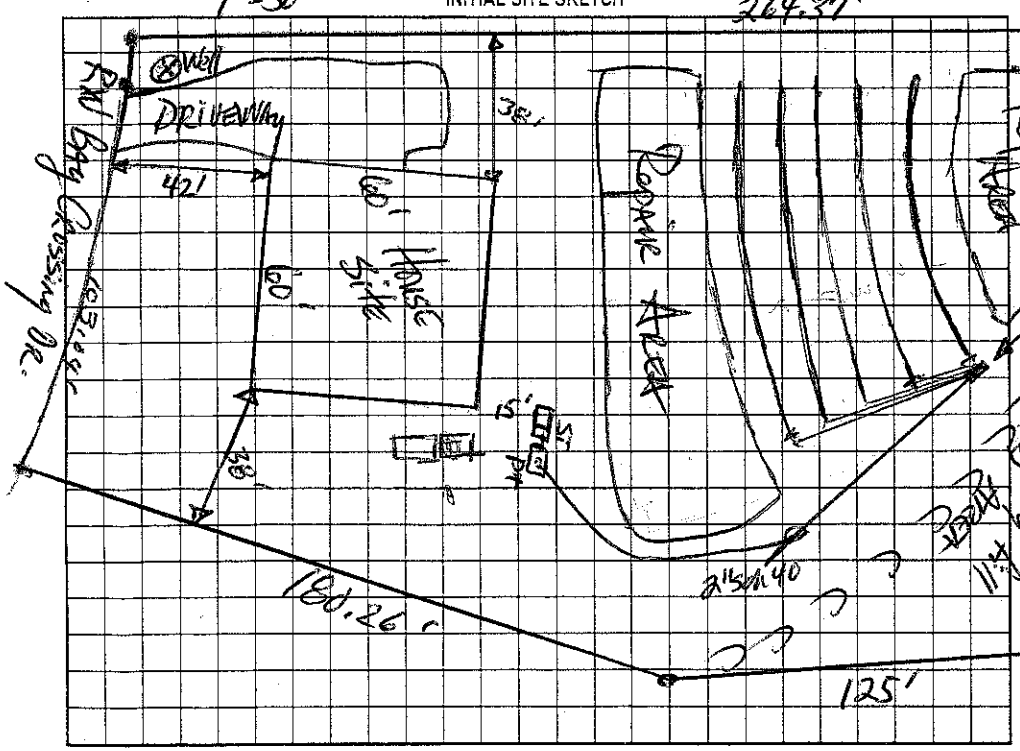

AS BUILT SKETCH

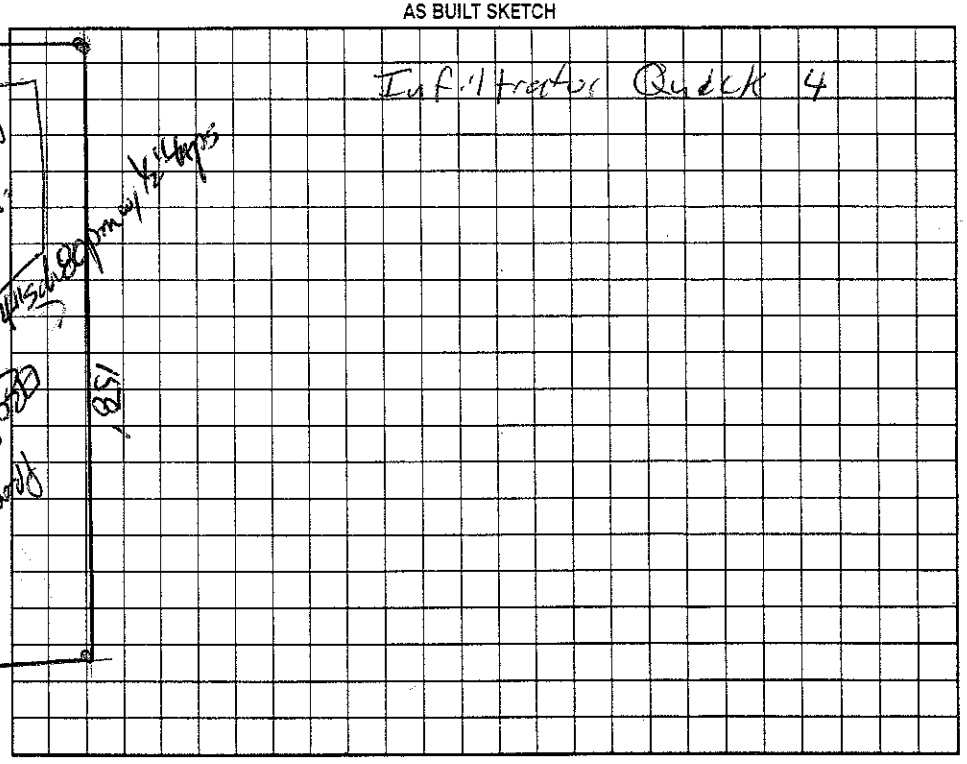

Permit can be suspended or revoked if any false information is supplied toward securing the permit/any unauthorized changes are made to the site/any unauthorized changes are made in the installation of the system. Improvement Permit with plat valid without expiration. Improvement Permit with site plan valid for sixty months. Authorization to Construct is valid for a period equal to that of Improvement Permit – not to exceed sixty months.

Signed: date 6/17/05 Installed by: Abernathy

Improvement Permit by: date 6-10-05 Operation Permit by: RS date 4/15/06

Authorization to Construct by: RS date 8/24/05 Existing System Inspection by: date

HEALTH DEPT. COPY: WHITE OWNER COPY (FINAL): YELLOW OWNER COPY (INITIAL): PINK