3:30

IREDELL COUNTY HEALTH DEPARTMENT

STATESVILLE 704-878-5305 ☑ MOORESVILLE 704-664-5281

IMPROVEMENT PERMIT / AUTHORIZATION TO CONSTRUCT / OPERATION PERMIT / EXISTING SYSTEM INSPECTION

PERMIT # 173545 PIN # 4639-72-4564 DATE 9-24-12

OWNER or APPLICANT BRANDON TREGO PHONE: Business 704-503-4123 Home:

OWNER or APPLICANT ADDRESS 1605 COPPERPLATE RD. CHARLOTTE 28262

LOCATION / DIRECTIONS PERTH, TL LIRA, TR BAY CROSSING, TR BAY SHORE, ON L

SUBDIVISION BAY CROSSING BLOCK / SECTION LOT # 55 LOT AREA .961 AC DESIGN FLOW 480 L.T.A.R. .3

Septic Tank 1000 Gallons: STB 4441 Date 4-14-14
Pump Tank 1000 Gallons: PT 283 Date 5-12-14
Pump Make Goulds Model WE0312M V Serial #
Nitrification Field No Fields 1 No Lines 4 Linear Feet 267'
Trench Width 24" Max. Trench Bottom Depth 36" Gravel Depth —

☑ New System ☐ Repair ☐ Expansion System Type I II III (IV) V VI
System Description: LP- PANEL BLOCK
Repair System Description: SAME
Maintenance Agreement Required ☑ YES ☐ NO
☐ GRAVITY ☑ PRESSURE


☑ Residence No. Bedrooms 4
☐ Business No. Persons
☐ Other No. Employees
☐ Slab ☐ Crawl Space
☑ Basement w/plumbing ☐ Basement w/o plumbing

Water Supply: ☑ Private ☐ Public ☐ Community


Comments / Conditions

Comments / Conditions
Drilled 5/32" hole
6/17/14 Checked tanks, lines, supply line 30" under drive

INITIAL SITE SKETCH

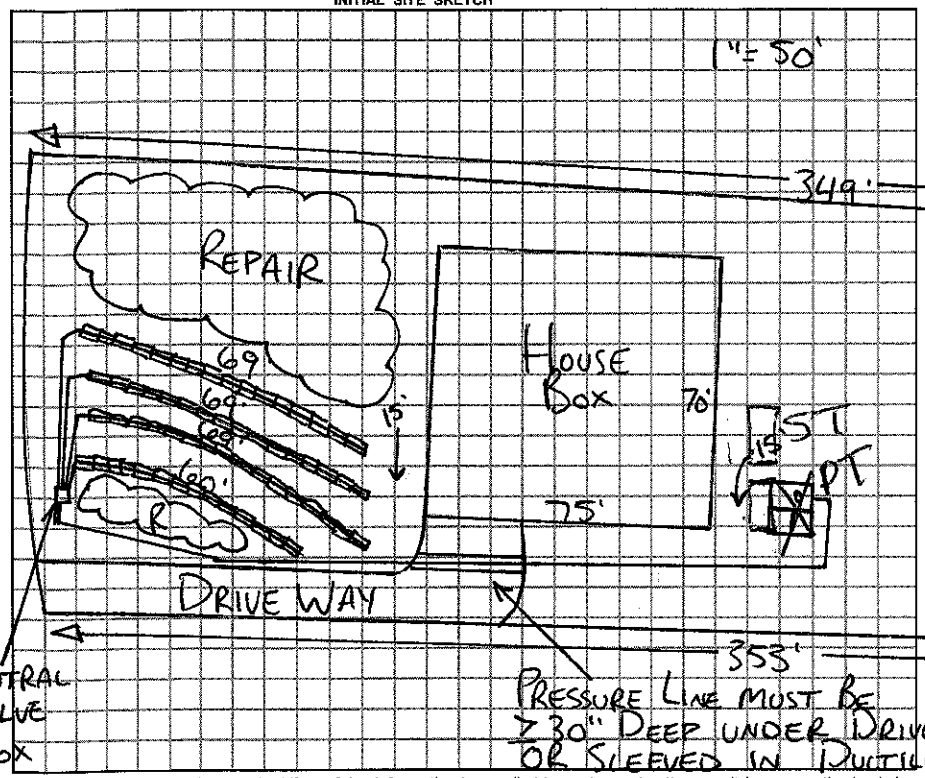

AS BUILT SKETCH

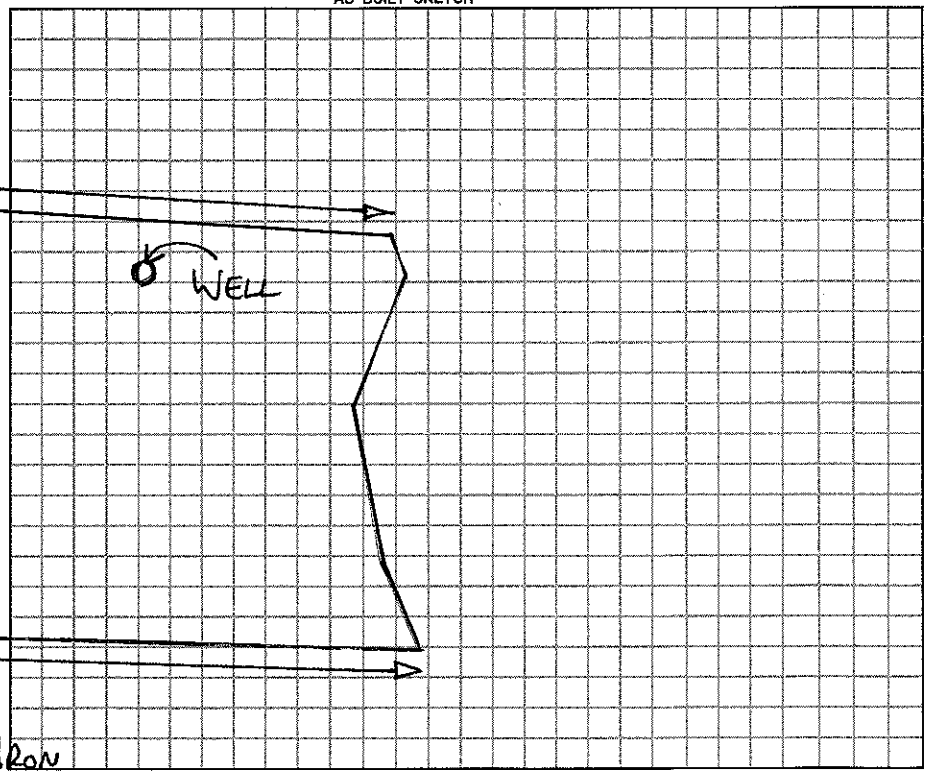

Permit can be suspended or revoked if any false information is supplied toward securing the permit / any unauthorized changes are made to the site / any unauthorized changes are made in the installation of the system.

☐ *IMPROVEMENT PERMIT w / plat valid without expiration.* ☑ *IMPROVEMENT PERMIT w / site plan valid for 60 mos.* ☐ *AUTHORIZATION TO CONSTRUCT valid for period equal to IMPROVEMENT PERMIT-not to exceed 60 mo.*

Owner / Applicant Signature: Brandon Trego Date 10/12/12

Improvement Permit by: REHS Date 9-24-12

Authorization to Construct by: Date 9/3/13

Installed by: Richard Abernathy

Operation Permit by: Date: 8/6/14

Existing System Inspected by: Date:

YOU SHOULD CONTACT A LOCATOR SERVICE PRIOR TO ANY EXCAVATION.

WHITE COPY Environmental Health YELLOW COPY (Final) Owner / Applicant PINK COPY (Initial) Owner / Applicant