IREDELL COUNTY HEALTH DEPARTMENT

STATESVILLE 704-878-5305 MOORESVILLE 704-664-5281

IMPROVEMENT PERMIT / AUTHORIZATION TO CONSTRUCT / OPERATION PERMIT / EXISTING SYSTEM INSPECTION

PERMIT# 125296 PIN# 4639-61-5536.057 T2 T512 DATE May 24, 05

OWNER OR CONTRACTOR Heath Properties Inc. PHONE: Business Home

ADDRESS 885 N. Hwy 16, Denver, N.C. 28037

LOCATION Parcel(N) TL Link Lane TR Bay Crossing Dr. to end TR Bay Shore Loop on left

SUBDIVISION Bay Crossing BLOCK / SECTION LOT 57 LOT AREA 1.16 Ac SITE CLASS. 1 3 DESIGN FLOW 440gpd L.T.A.R. .25-.3

Septic Tank: 1000 Gallons; STB 338 Date 1-28-05

Pump Tank: Gallons; PT Date

Pump Make: Model Serial No.

Nitrification Field: No Fields 1 Square Feet 1440 Linear Feet 480

No Lines 5 Trench Width 36" Max Trench Bottom Depth 36"

☒ New System ☐ Repair System Type: I II III IV V VI

System Description: Gravity 25% reduction "accepted"

Repair System Description: LPP/BPS

Maintenance Agreement Required: ☐ Yes ☒ No in futrity

Gravel Depth NA

☒ House/Mod. Home No. Bedrooms 4

☐ Mobile Home No. Bathrooms

☐ Business No. Employees

☐ Other

☐ Slab ☒ Crawl Space ☐ Basement w/plumbing ☐ Basement wo/plumbing


Water Supply: ☒ Individual ☐ Public ☐ Community

Comments:/Conditions:


Comments:/Conditions: Must keep future pool at least 15ft from Septic System

1"=50'

INITIAL SITE SKETCH

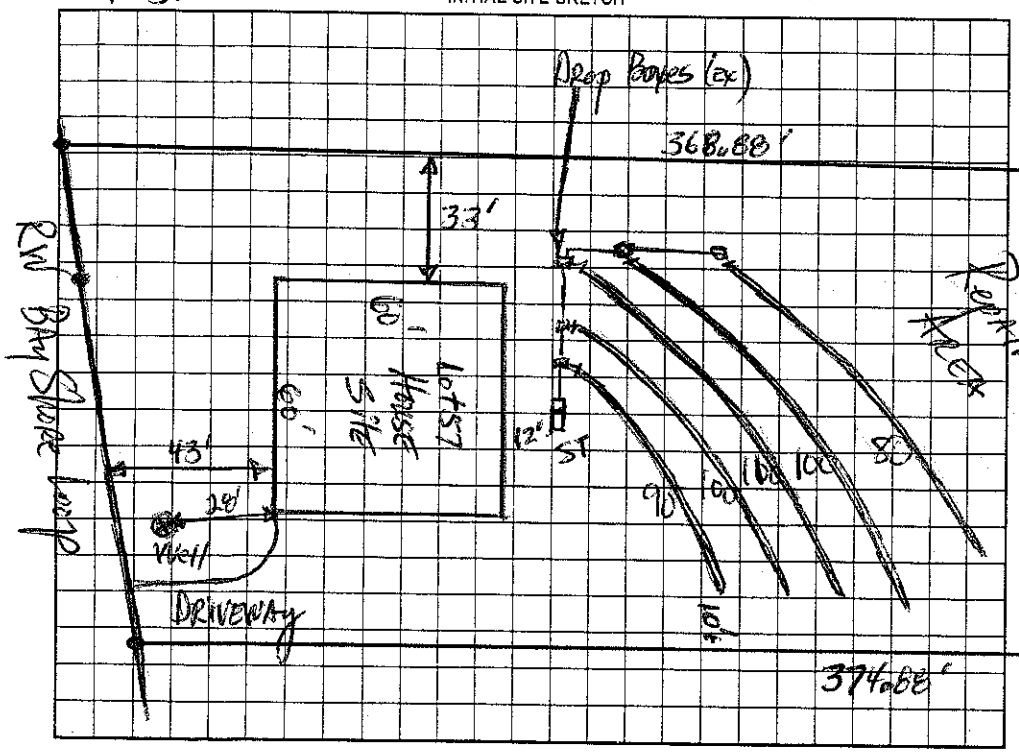

AS BUILT SKETCH

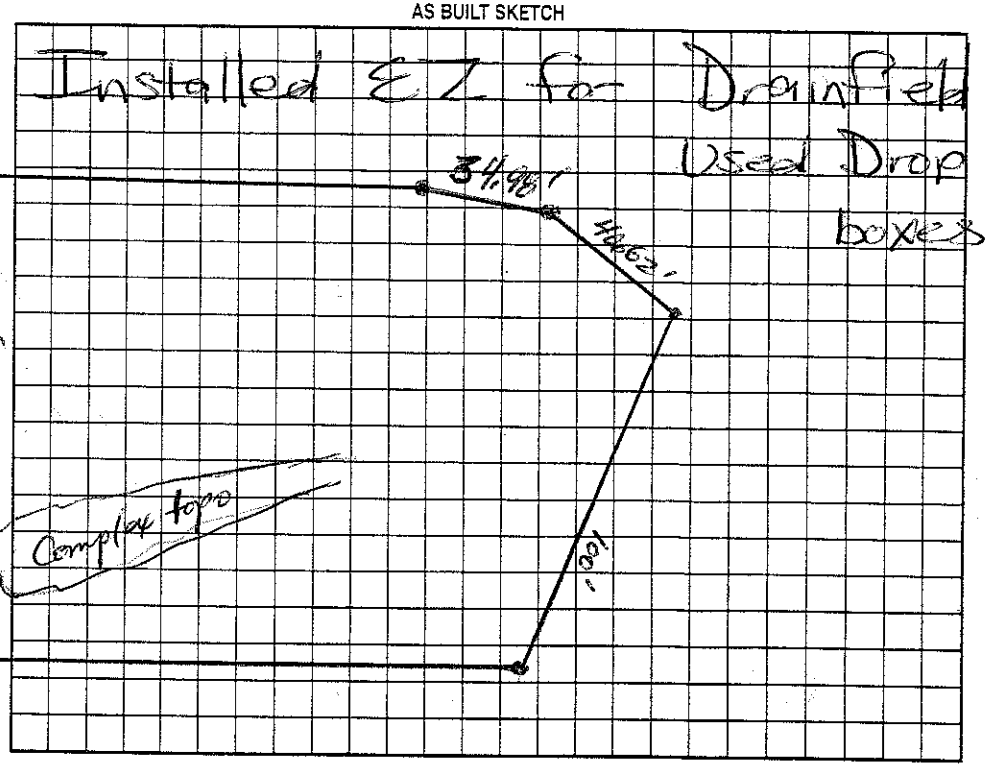

Permit can be suspended or revoked if any false information is supplied toward securing the permit/any unauthorized changes are made to the site/any unauthorized changes are made in the installation of the system. Improvement Permit with plat valid without expiration. Improvement Permit with site plan valid for sixty months. Authorization to Construct is valid for a period equal to that of Improvement Permit – not to exceed sixty months.

Signed: date 6/1/05 Installed by: R&H Dotson RS

Improvement Permit by: date 5-24-05 Operation Permit by: Maria H Dotson date 3/8/06

Authorization to Construct by: date 6/16/05 Existing System Inspection by: date

HEALTH DEPT. COPY: WHITE OWNER COPY (FINAL): YELLOW OWNER COPY (INITIAL): PINK