IREDELL COUNTY HEALTH DEPARTMENT

STATESVILLE 704-878-5305 MOORESVILLE 704-664-5281

IMPROVEMENT PERMIT / AUTHORIZATION TO CONSTRUCT / OPERATION PERMIT / EXISTING SYSTEM INSPECTION

PERMIT# 125301 PIN# 4639-~~61~~ ~~5556.06~~ 72-9142 DATE 1/13/06

OWNER OR CONTRACTOR La Monica Bldr. PHONE: Business 704-575-7505 Home

ADDRESS 145 Sleepy Cove Mooresville NC 28117

LOCATION Perth Rd TL Liva Ln, TR Bay Crossing, TR Bay Shore Lp, at End

SUBDIVISION Bay Crossing BLOCK / SECTION LOT 61 LOT AREA 1.09Ac SITE CLASS. PS DESIGN FLOW 480 L.T.A.R. 0.3

Septic Tank: 1500 Gallons; STB 338 Date 4/18/06
Pump Tank: Gallons; PT Date
Pump Make: Model Serial No.
Nitrification Field: No Fields 1 Square Feet 1260 Linear Feet 400
No Lines 3 or 4 Trench Width 36" Max Trench Bottom Depth 36" Gravel Depth —

☒ New System ☐ Repair System Type: I (II) III, IV, V, VI
System Description: Gravity 25% Reduct.
Repair System Description: Pump 25% Reduct.
Maintenance Agreement Required: ☐ Yes ☒ No

☒ House/Mod. Home No. Bedrooms 4
☐ Mobile Home No. Bathrooms
☐ Business No. Employees
☐ Other

☐ Slab ☒ Crawl Space ☐ Basement w/plumbing ☐ Basement wo/plumbing


Water Supply: ☒ Individual ☐ Public ☐ Community

Comments:/Conditions:


1" = 50'

Comments:/Conditions:

INITIAL SITE SKETCH

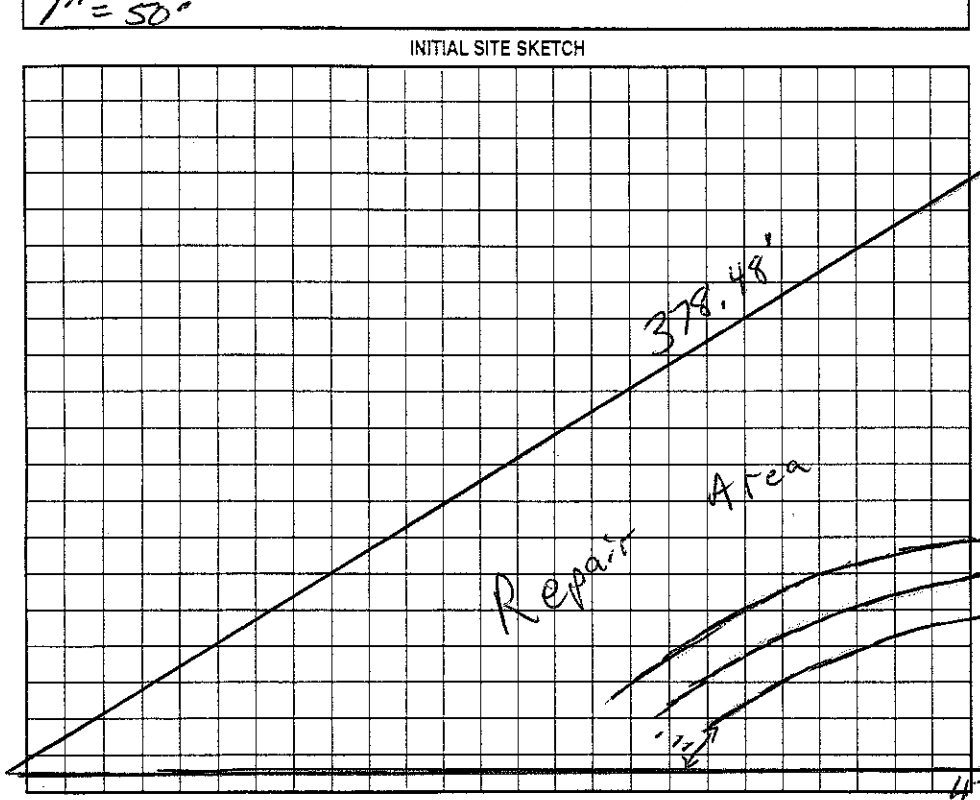

AS BUILT SKETCH

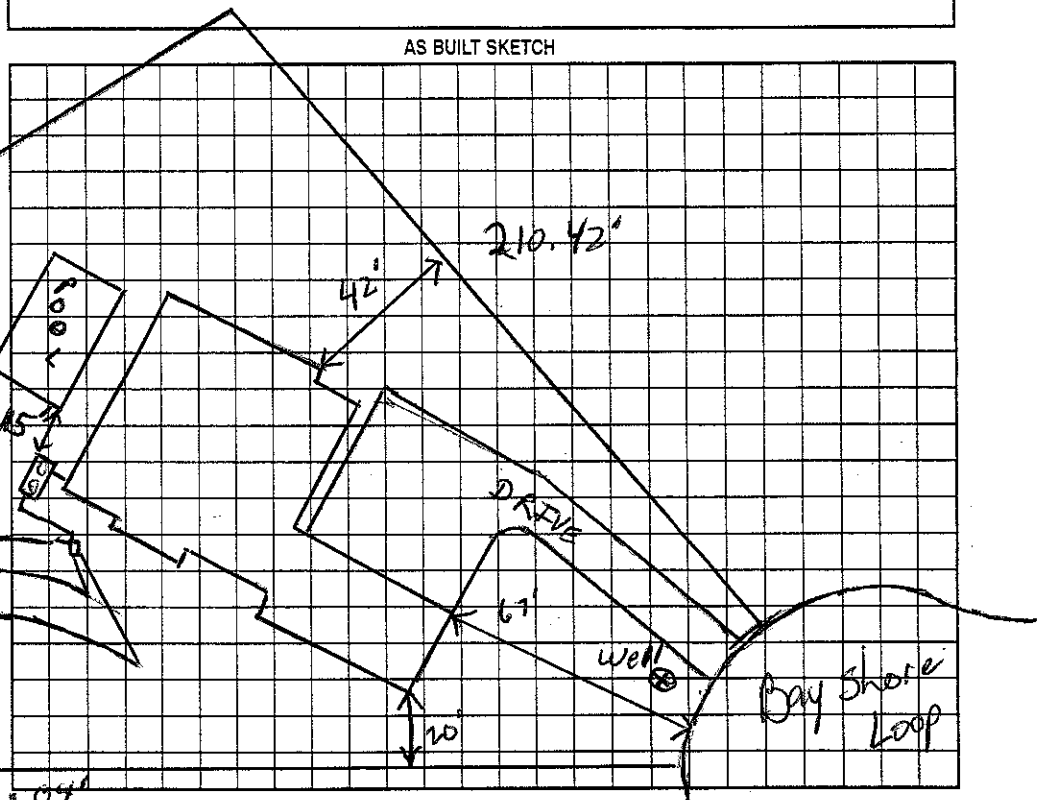

Permit can be suspended or revoked if any false information is supplied toward securing the permit/any unauthorized changes are made to the site/any unauthorized changes are made in the installation of the system. Improvement Permit with plat valid without expiration; Improvement Permit with site plan valid for sixty months. Authorization to Construct is valid for a period equal to that of Improvement Permit – not to exceed sixty months.

Signed: [signature] date 1/13/06 Installed by: Dobson

Improvement Permit by: [signature] RS date 1/13/06 Operation Permit by: Wesley Sparks R.S. date 7/14/06

Authorization to Construct by: [signature] RS date 1/13/06 Existing System Inspection by: date

HEALTH DEPT COPY: WHITE OWNER COPY (FINAL): YELLOW OWNER COPY (INITIAL): PINK