IREDELL COUNTY HEALTH DEPARTMENT

STATESVILLE 704-878-5305 MOORESVILLE 704-664-5281

IMPROVEMENT PERMIT / AUTHORIZATION TO CONSTRUCT / OPERATION PERMIT / EXISTING SYSTEM INSPECTION

PERMIT# 125298 PIN# 4639-55-5559.059 92 9452 DATE 9-29-05

OWNER OR CONTRACTOR Mark & Davel Di Pietro PHONE: Business 664-0234 Home 664-5669 634-0948

ADDRESS 102 Easy Street Mooresville NC 28117

LOCATION Perth Rd (N) TL Liva Lane TR Bay Crossing Dr TR Bay Shore Loop at end

SUBDIVISION Bay Crossing BLOCK / SECTION ____ LOT 59 LOT AREA 1.334 Acre SITE CLASS PS DESIGN FLOW 450gpd L.T.A.R. .3 Initial / .25 - 3 Repair

Septic Tank: 1000+ Gallons; STB 3 Date ____

Pump Tank: ____ Gallons; PT ____ Date ____

Pump Make: ____ Model ____ Serial No. ____

Nitrification Field: No Fields 1 Square Feet 1200' Linear Feet 400'

No Lines 3 Trench Width 36" Max Trench Bottom Depth 36"

X New System ☐ Repair System Type: I, II, III, IV, V, VI

System Description: Gravity - 25% Reduction Accepted

Repair System Description: Grav/Pump 25-50% Reduct

Maintenance Agreement Required: ☐ Yes X No

Gravel Depth N/A

X House/Mod. Home No. Bedrooms 4

☐ Mobile Home No. Bathrooms ____

☐ Business No. Employees ____

☐ Other ____

☐ Slab ☐ Crawl Space X Basement w/plumbing ☐ Basement wo/plumbing


Water Supply: X Individual ☐ Public ☐ Community

Comments/Conditions: Keep pool at least 15ft from Septic System. Keep well at least 100' from any Septic system.

Comments/Conditions: Note: Must keep basement floor & Stub out for plumbing above Septic System to keep Gravity flow to drainfield. Cutting house pad lower (elevation) then Septic System will void permit.


INITIAL SITE SKETCH

1:50

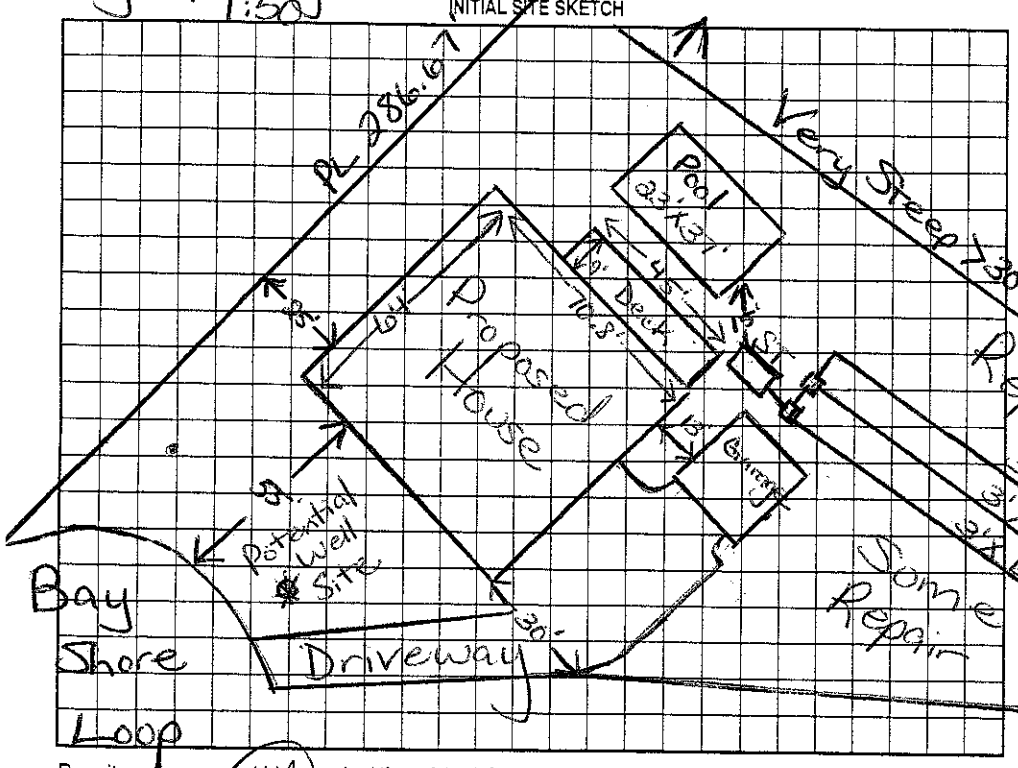

AS BUILT SKETCH

Installed Brick 4 as drawn Used "Built in Drop boxes"

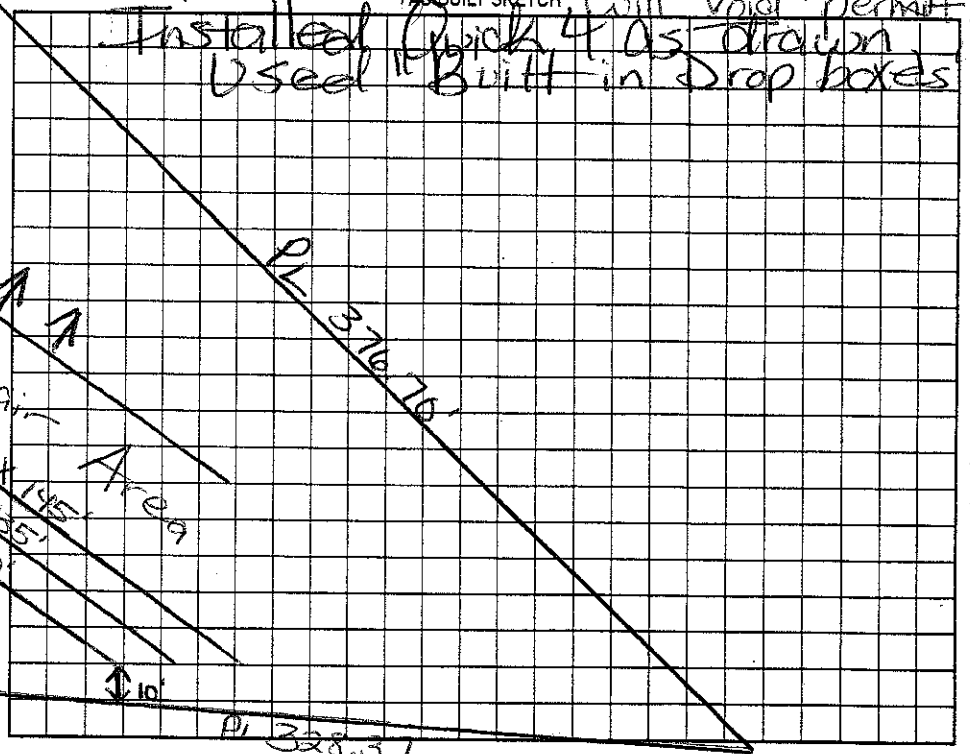

Permit can be suspended or revoked if any false information is supplied toward securing the permit/any unauthorized changes are made to the site/any unauthorized changes are made in the installation of the system. Improvement Permit with plat valid without expiration. Improvement Permit with site plan valid for sixty months. Authorization to Construct is valid for a period equal to that of Improvement Permit – not to exceed sixty months.

Signed: ____ date 9/30/05

Improvement Permit by: Maria H. Dotson RS date 9/29/05

Authorization to Construct by: Maria H. Dotson RS date 9/29/05

Installed by: Richard Abernathy date ____

Operation Permit by: Maria H. Dotson RS date 9/7/07

Existing System Inspection by: ____ date ____

HEALTH DEPT. COPY: WHITE OWNER COPY (FINAL): YELLOW OWNER COPY (INITIAL): PINK