IREDELL COUNTY HEALTH DEPARTMENT

Statesville Office (704) 878-5305 Mooresville Office (704) 660-3625 PERMIT # 152550

IMPROVEMENT PERMIT / AUTHORIZATION TO CONSTRUCT / OPERATION PERMIT / EXISTING SYSTEM

PIN # 4639737673

APPLICANT: MERITAGE HOMES APPLICANT ADDRESS: 7761 BALLANTYNE COMM. PKWY

SITE ADDRESS: 189 BELFRY LOOP PHONE: 704-351-5405 ALT. PHONE:

SITE DIRECTIONS: PERTH, BELLS CROSSING, BELFRY

SUBDIVISION: BELLS CROSSING SECTION: LOT # 84 LOT AREA: 1 AC DESIGN FLOW: 480 L.T.A.R.: .275

Septic Tank 1000 (gal) STB 760 Date 4-28
Pump Tank 1000 (gal) PT 363 Date 7-3
Pump Make MYERS Model 1/2 HP Serial #
Nitrification Fields 1 # Lines 7 Linear Ft: 484'
Trench Width 36" Max. Trench Bottom Depth ~~24"~~ Gravel Depth —


☒ New System ☐ Repair ☐ Expansion System Type: I II III IV V VI
System Description: PM - 25% REDUCTION
Repair System Description: PANEL BLOCK
Maintenance Agreement Required: ☐ YES ☒ NO
☒ GRAVITY ☐ PRESSURE

☒ Residence No. Bedrooms 4
☐ Business No. Persons
☐ Other No. Employees
☒ Slab ☐ Crawl Space
☐ Basement w/plumbing ☐ Basement w/o plumbing


Water Supply
☐ Private
☐ Public
☒ Community

Comments / Conditions:

INITIAL SITE SKETCH

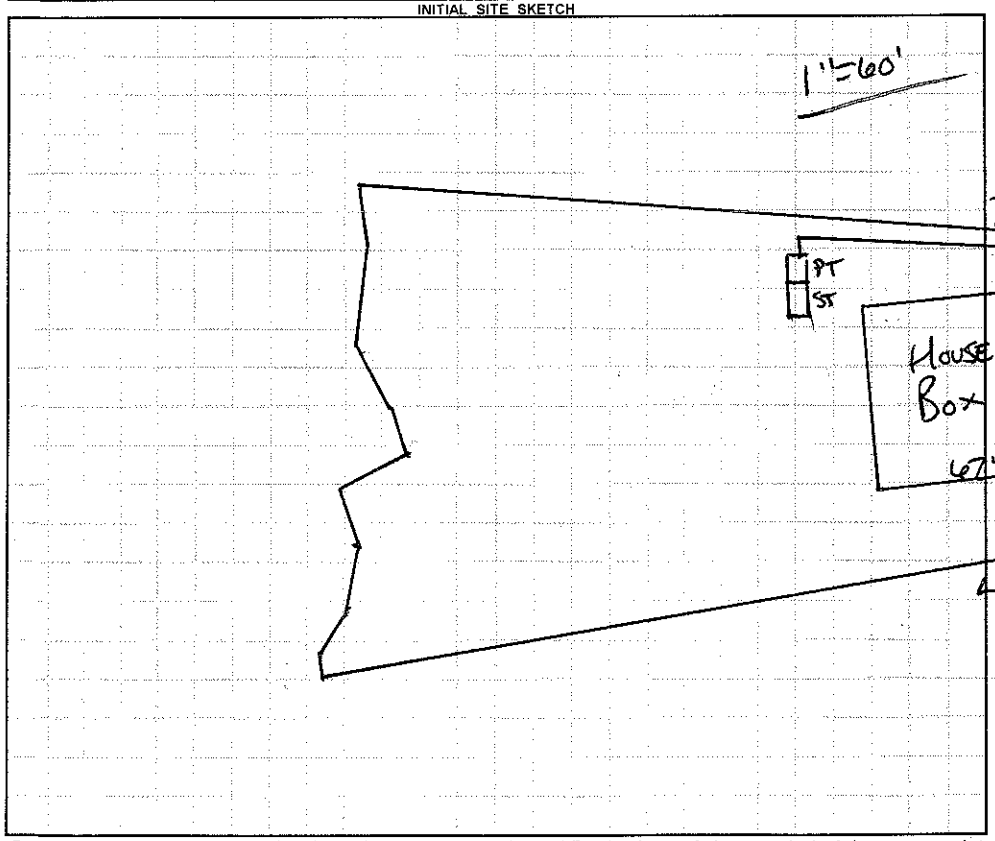

AS BUILT SKETCH

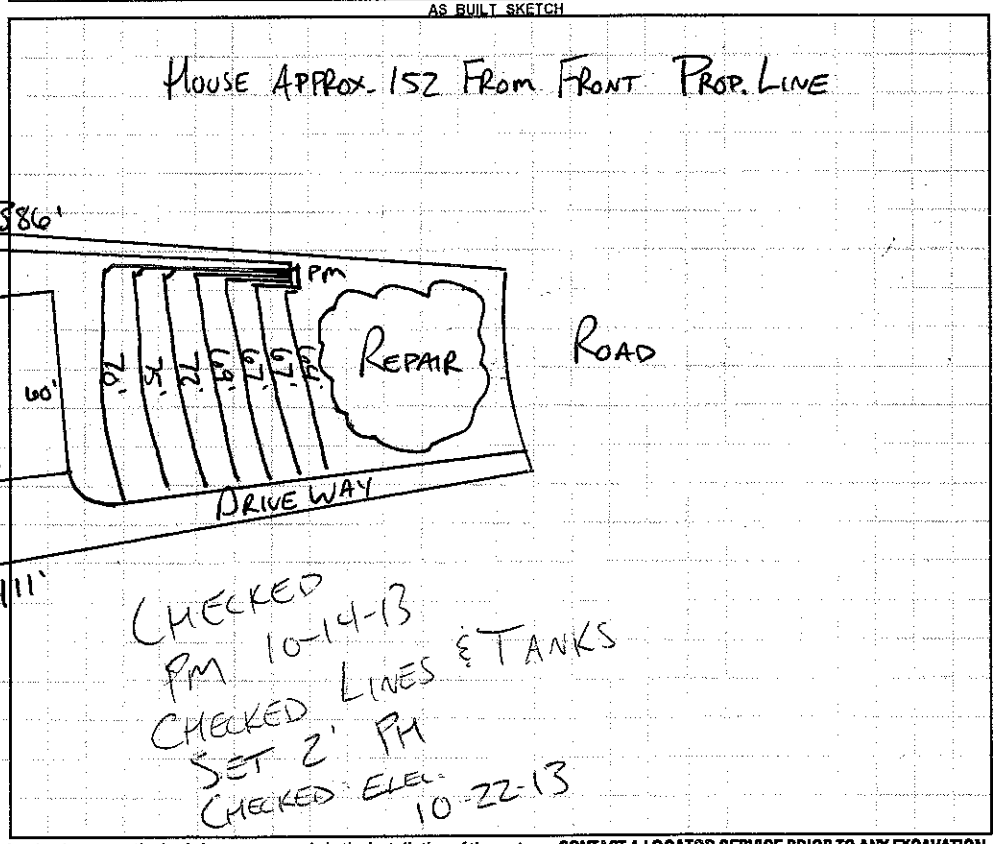

Permit can be suspended or revoked if any false information is supplied toward securing the permit / any unauthorized changes are made to the site / any unauthorized changes are made in the installation of the system. **CONTACT A LOCATOR SERVICE PRIOR TO ANY EXCAVATION**

☐ **IMPROVEMENT PERMIT** *with plat valid without expiration* ☒ **IMPROVEMENT PERMIT** *with site plan valid for 60 mos.* ☒ **AUTHORIZATION TO CONSTRUCT** *valid for period equal to IMPROVEMENT PERMIT--not to exceed 60 mo.*

Owner / Applicant Signature: Date: 2-19-13 Installed by:

IMPROVEMENT PERMIT by: Date: 2-19-13 OPERATION PERMIT by: CPC Date: 10-22-13

AUTHORIZATION TO CONSTRUCT by: Date: 5-20-13 Existing System Inspected by: Date:

Health Dept. Copy - WHITE Applicant (Final Approval) - YELLOW Applicant (Conditional Approval) - PINK