IREDELL COUNTY HEALTH DEPARTMENT

STATESVILLE 704-878-5305 MOORESVILLE 704-664-5281

IMPROVEMENT PERMIT / AUTHORIZATION TO CONSTRUCT / OPERATION PERMIT / EXISTING SYSTEM INSPECTION

PERMIT# 124985 PIN# 4639644034 0.044 4639 74 1921 DATE 8-28-06

OWNER OR APPLICANT J&K Developers PHONE: Business (704) 516-4355 Home (336) 469-2180

ADDRESS 3843 Gordon St. Terrell, NC 28682

LOCATION Perth Rd N: TL Fern Hill TL Northington Woods Dr. TL Waterbury Dr at end

SUBDIVISION Northington Wds. BLOCK / SECTION ____ LOT 41 LOT AREA .851Acre SITE CLASS. PS DESIGN FLOW 480gpd T.A.R. .25

Septic Tank: 1000 Gallons; STB 1000 Date 6-29-06 ☒ New System ☐ Repair ☐ Expansion System Type: I II III IV V VI ☒ House/Mod. Home No. Bedrooms 4 Water Supply: ☒ Individual

Pump Tank: 1000 Gallons; PT 274 Date 7-17-06 System Description: Pump-up Panel Blck ☐ Mobile Home No. Persons ____ ☐ Public

Pump Make: Goulds Model PES1M Serial No. 5G2c0519 Repair System Description: Same ☐ Business No. Employees ____ ☐ Community


Nitrification Field: No. Fields 1 Square Feet 640' Linear Feet 320' Maintenance Agreement Required: ☒ Yes ☐ No ☐ Other ____

No. Lines 3 (See Note) Trench Width min. 24" Max Trench Bottom Depth 36 Gravel Depth ____ ☐ Gravity ☐ Pressure ☐ Slab ☐ Crawl Space ☐ Basement w/plumbing ☐ Basement wo/plumbing


Comments:/Conditions: *Okay to Center Feeal lines & install 6 lines instead of 3.
*Use "in line" filter on PT.

Comments:/Conditions: Keep tanks at least 10' from house.
*Note: Future pool must be at least 15ft from Septic System
Checked tanks, lines & pressure. 9/8/06
Checked feet & ok AS BUILT SKETCH 9/26/06 mg

Scale 1:50 INITIAL SITE SKETCH

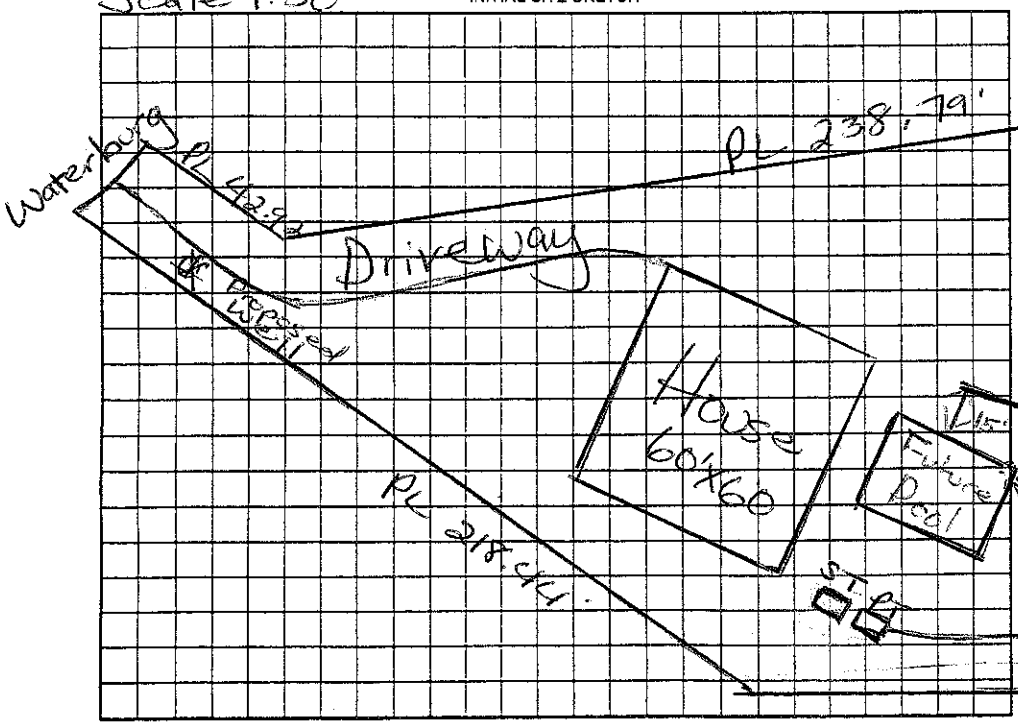

AS BUILT SKETCH

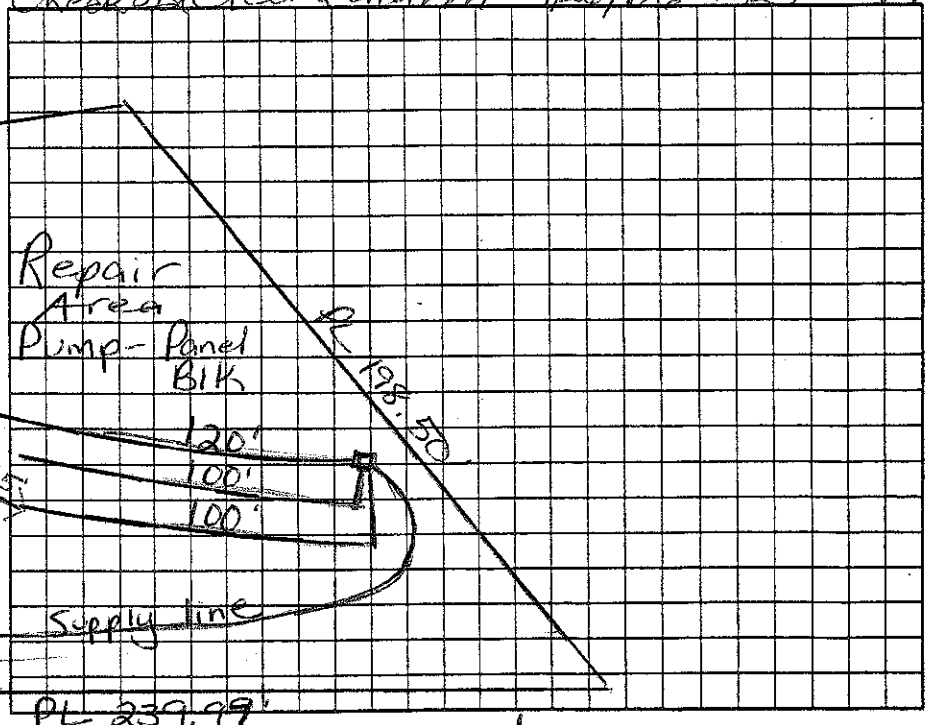

Permit can be suspended or revoked if any false information is supplied toward securing the permit/any unauthorized changes are made to the site/any unauthorized changes are made in the installation of the system. Improvement Permit with plat valid without expiration ☐ Improvement Permit with site plan valid for sixty months ☐ Authorization to Construct is valid for a period equal to that of Improvement Permit – not to exceed sixty months.

Signed: Sandy Huggins date 8-29-06 Installed by: Richard Abernathy

Improvement Permit by: Maria H. Dotson RS date 8/28/06 Operation Permit by: Maria H. Dotson RS date 10/11/06

Authorization to Construct by: Maria H. Dotson RS date 8/28/06 Existing System Inspection by: ____ date ____

HEALTH DEPT. COPY: WHITE OWNER COPY (FINAL): YELLOW OWNER COPY (INITIAL): PINK