IREDELL COUNTY HEALTH DEPARTMENT

STATESVILLE 704-878-5305 MOORESVILLE 704-664-5281

IMPROVEMENT PERMIT / AUTHORIZATION TO CONSTRUCT / OPERATION PERMIT / EXISTING SYSTEM INSPECTION

PERMIT# 152520 PIN# ~~4639-83-4045.076~~ 4639746401 DATE 9-11-08

OWNER OR APPLICANT Bells Crossing LLC PHONE: Business 704-663-1600 Home

ADDRESS 127 S Promenade Dr Mooresville NC 28117

LOCATION Perth, TL Bells Crossing, on R

SUBDIVISION Bells Crossing BLOCK / SECTION 0 LOT 76 LOT AREA 1.51 AC SITE CLASS. PS DESIGN FLOW 460 L.T.A.R. .25

Septic Tank: 1000 Gallons: STB 2071-1060 Date

Pump Tank: Gallons: PT Date

Pump Make: Model Serial No.

Nitrification Field: No Fields 1 Square Feet 1440' Linear Feet 480'

No Lines 5 Trench Width 36" Max Trench Bottom Depth 36" Gravel Depth — ☒ Gravity ☐ Pressure

☒ New System ☐ Repair ☐ Expansion System Type: I II III IV V VI

System Description: Gravity 25% Red.

Repair System Description: LP - Panel Block

Maintenance Agreement Required: ☐ Yes ☒ No Initially

☒ House/Mod. Home ☐ Mobile Home ☐ Business ☐ Other

No. Bedrooms 4 No. Persons No. Employees

Water Supply: ☐ Individual ☐ Public ☒ Community

☐ Slab ☒ Crawl Space ☐ Basement w/plumbing ☐ Basement wo/plumbing


Comments:/Conditions: 1) Install per plan specs 2) Maintain Setbacks

Comments:/Conditions:

INITIAL SITE SKETCH

See Attached by Rollins Soil & Environmental Services

AS BUILT SKETCH

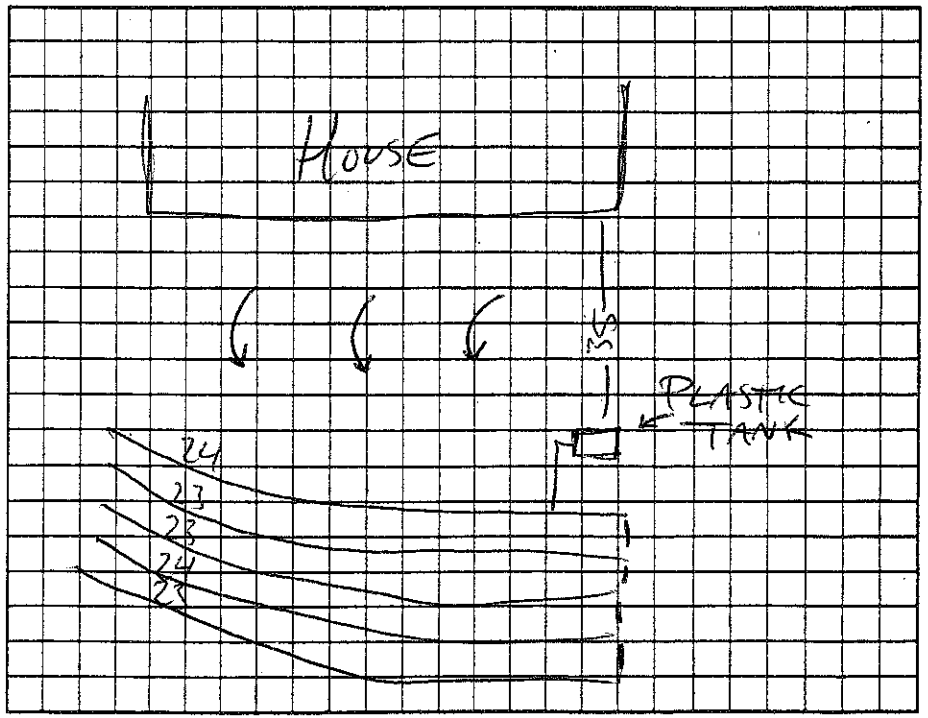

Permit can be suspended or revoked if any false information is supplied toward securing the permit/any unauthorized changes are made to the site/any unauthorized changes are made in the installation of the system. Improvement Permit with plat valid without expiration ☒ Improvement Permit with site plan valid for sixty months ☐ Authorization to Construct is valid for a period equal to that of Improvement Permit – not to exceed sixty months.

Signed: date 11/10/08 Installed by:

Improvement Permit by: date 9-11-08 Operation Permit by: date 5-31-13

Authorization to Construct by: date 4/31/13 Existing System Inspection by: date

HEALTH DEPT. COPY: WHITE OWNER COPY (FINAL): YELLOW OWNER COPY (INITIAL): PINK