IREDELL COUNTY HEALTH DEPARTMENT

STATESVILLE 704-878-5305 MOORESVILLE 704-664-5281

IMPROVEMENT PERMIT / AUTHORIZATION TO CONSTRUCT / OPERATION PERMIT / EXISTING SYSTEM INSPECTION

PERMIT # 152008 PIN # 4639-74-7170 DATE 11-29-12

OWNER or APPLICANT MERITAGE HOMES PHONE: Business 704-351-5405 ~~Home:~~ > GERALD BOSWELL

OWNER or APPLICANT ADDRESS 7761 BALLANTYNE COMMONS PKWY

LOCATION / DIRECTIONS PERTH, TL BELLS CROSSING, CORNER OF BELFRY

SUBDIVISION BELLS CROSSING BLOCK / SECTION LOT # 200 LOT AREA 1.01 AC DESIGN FLOW 600 L.T.A.R. ,3

Septic Tank 1500 Gallons: STB 964 Date 10-15

Pump Tank 1500 Gallons: PT 353 Date 12-8

Pump Make Model Serial #

Nitrification Field No Fields 1 No Lines 5 Linear Feet 500'

Trench Width 36" Max. Trench Bottom Depth 36" Gravel Depth —

☒ New System ☐ Repair ☐ Expansion System Type I II (III) IV V VI

System Description: PM-25% REDUCTION

Repair System Description: LP PANEL BLOCK

Maintenance Agreement Required ☐ YES ☒ NO

☐ GRAVITY ☒ PRESSURE

☒ Residence No. Bedrooms 5

☐ Business No. Persons

☐ Other No. Employees

☒ Slab ☐ Crawl Space


☐ Basement w/plumbing ☐ Basement w/o plumbing

Water Supply: ☐ Private ☐ Public ☒ Community


Comments / Conditions

Comments / Conditions 11/24/13 Checked upper 2 lines Quick 12" Note: 13FT OC btw rows 4 & 5 4/26/13 Checked last 3 lines & supply lines to trenches

INITIAL SITE SKETCH

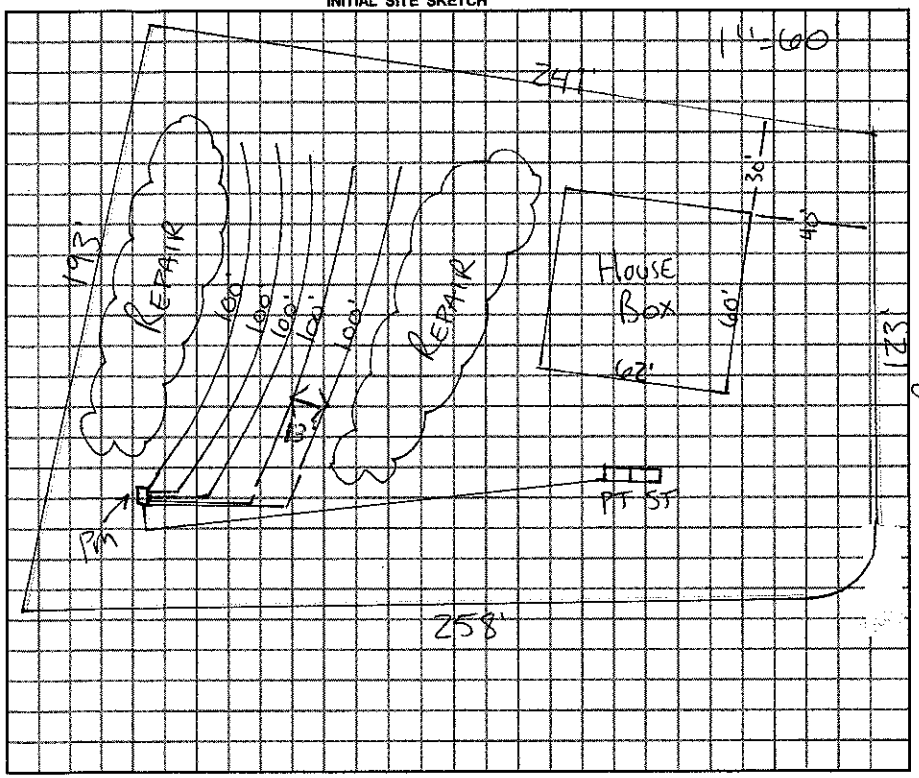

AS BUILT SKETCH

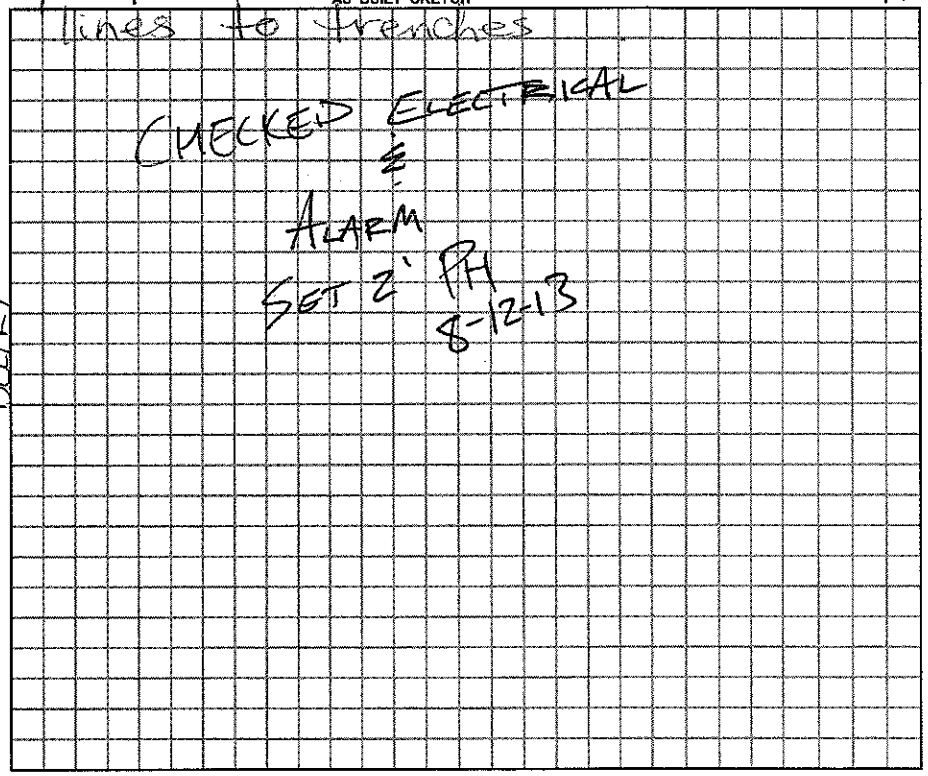

Permit can be suspended or revoked if any false information is supplied toward securing the permit / any unauthorized changes are made to the site / any unauthorized changes are made in the installation of the system.

☐ *IMPROVEMENT PERMIT w / plat valid without expiration.* ☒ *IMPROVEMENT PERMIT w / site plan valid for 60 mos.* ☒ *AUTHORIZATION TO CONSTRUCT valid for period equal to IMPROVEMENT PERMIT-not to exceed 60 mo.*

Owner / Applicant Signature: Gerald Boswell Date 12.6.12

Improvement Permit by: Date 11-29-12

Authorzation to Construct by: Date 11-29-12

YOU SHOULD CONTACT A LOCATOR SERVICE PRIOR TO ANY EXCAVATION.

Installed by: Carolina Pipe

Operation Permit by: Date: 8-12-13

Existing System Inspected by: Date:

WHITE COPY Environmental Health YELLOW COPY (Final) Owner / Applicant PINK COPY (Initial) Owner / Applicant