IREDELL COUNTY HEALTH DEPARTMENT

STATESVILLE 704-878-5305 MOORESVILLE 704-664-5281

IMPROVEMENT PERMIT / AUTHORIZATION TO CONSTRUCT / OPERATION PERMIT / EXISTING SYSTEM INSPECTION

PERMIT# 152515 206074 PIN# ~~4639-83-4045.074~~ 4639-74-8437 DATE 9-8-08

OWNER OR APPLICANT Bells Crossing LLC

ADDRESS 127 B Promenade Dr Mooresville NC 28117 PHONE: Business 704-662-1600 Home

LOCATION Perth, TL Bells Crossing, on R

SUBDIVISION Bells Crossing BLOCK / SECTION I LOT 74 LOT AREA .63 Ac SITE CLASS. PS DESIGN FLOW 480 L.T.A.R. .35

Septic Tank A 1000 Gallons; STB 70/4311D Date C31090
Pump Tank: Gallons; PT Date
Pump Make: Model Serial No.
Nitrification Field: No Fields 1 Square Feet 1110' Linear Feet 370'
No Lines 4 Trench Width 36" Max Trench Bottom Depth 36" Gravel Depth — ☒ Gravity ☐ Pressure ☐ Slab

☒ New System ☐ Repair ☐ Expansion System Type: I II III IV V VI
System Description: Gravity 25% Red
Repair System Description: Same
Maintenance Agreement Required: ☐ Yes ☒ No

☒ House/Mod. Home ☐ Mobile Home ☐ Business ☐ Other
No. Bedrooms 4 No. Persons 8 No. Employees
Crawl Space ✓ Basement w/plumbing ☐ Basement wo/plumbing


Water Supply: ☐ Individual ☐ Public ☒ Community

Comments:/Conditions: 1) Install per plan specs attached by Bollings Soil & Env. Services 2) Maintain Setbacks
A Plastic tank Used Infiltrator

Comments:/Conditions: Installed Quick 4 for Drainfield

INITIAL SITE SKETCH 1" = 40'

AS BUILT SKETCH

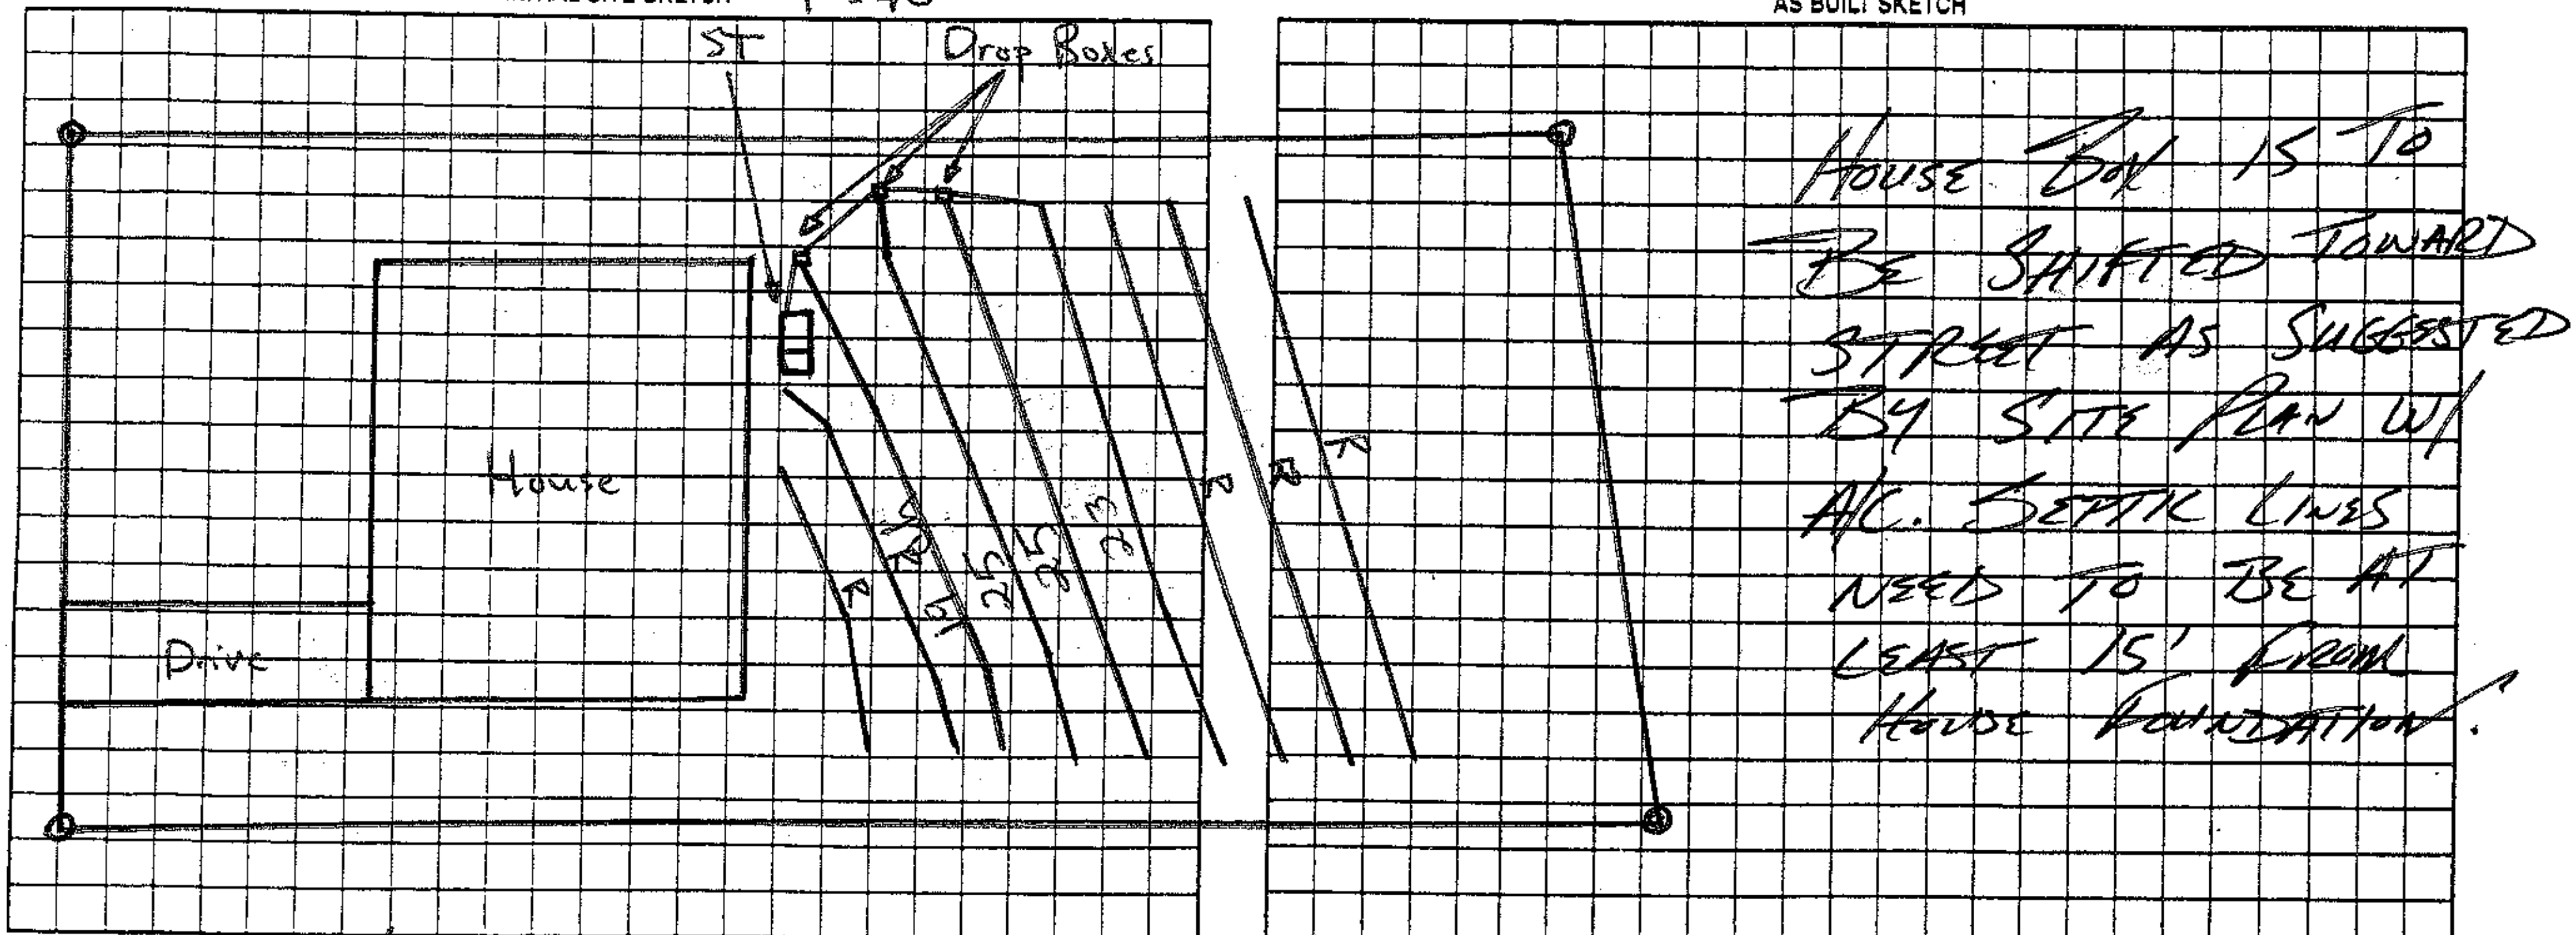

Permit can be suspended or revoked if any false information is supplied toward securing the permit/any unauthorized changes are made to the site/any unauthorized changes are made in the installation of the system. Improvement Permit with plat valid without expiration ☒ Improvement Permit with site plan valid for sixty months ☐ Authorization to Construct is valid for a period equal to that of Improvement Permit – not to exceed sixty months.

Signed: [signature] date 9/12/08

Improvement Permit by: [signature] date 9-8-08


Authorization to Construct by: [signature] APPROVED SEP 30 2014

Installed by: Carolina Pipe

Operation Permit by: Maria Dotson RS date 3/9/15

Existing System Inspection by: date

HEALTH DEPT. COPY: WHITE OWNER COPY (FINAL): YELLOW OWNER COPY (INITIAL): PINK

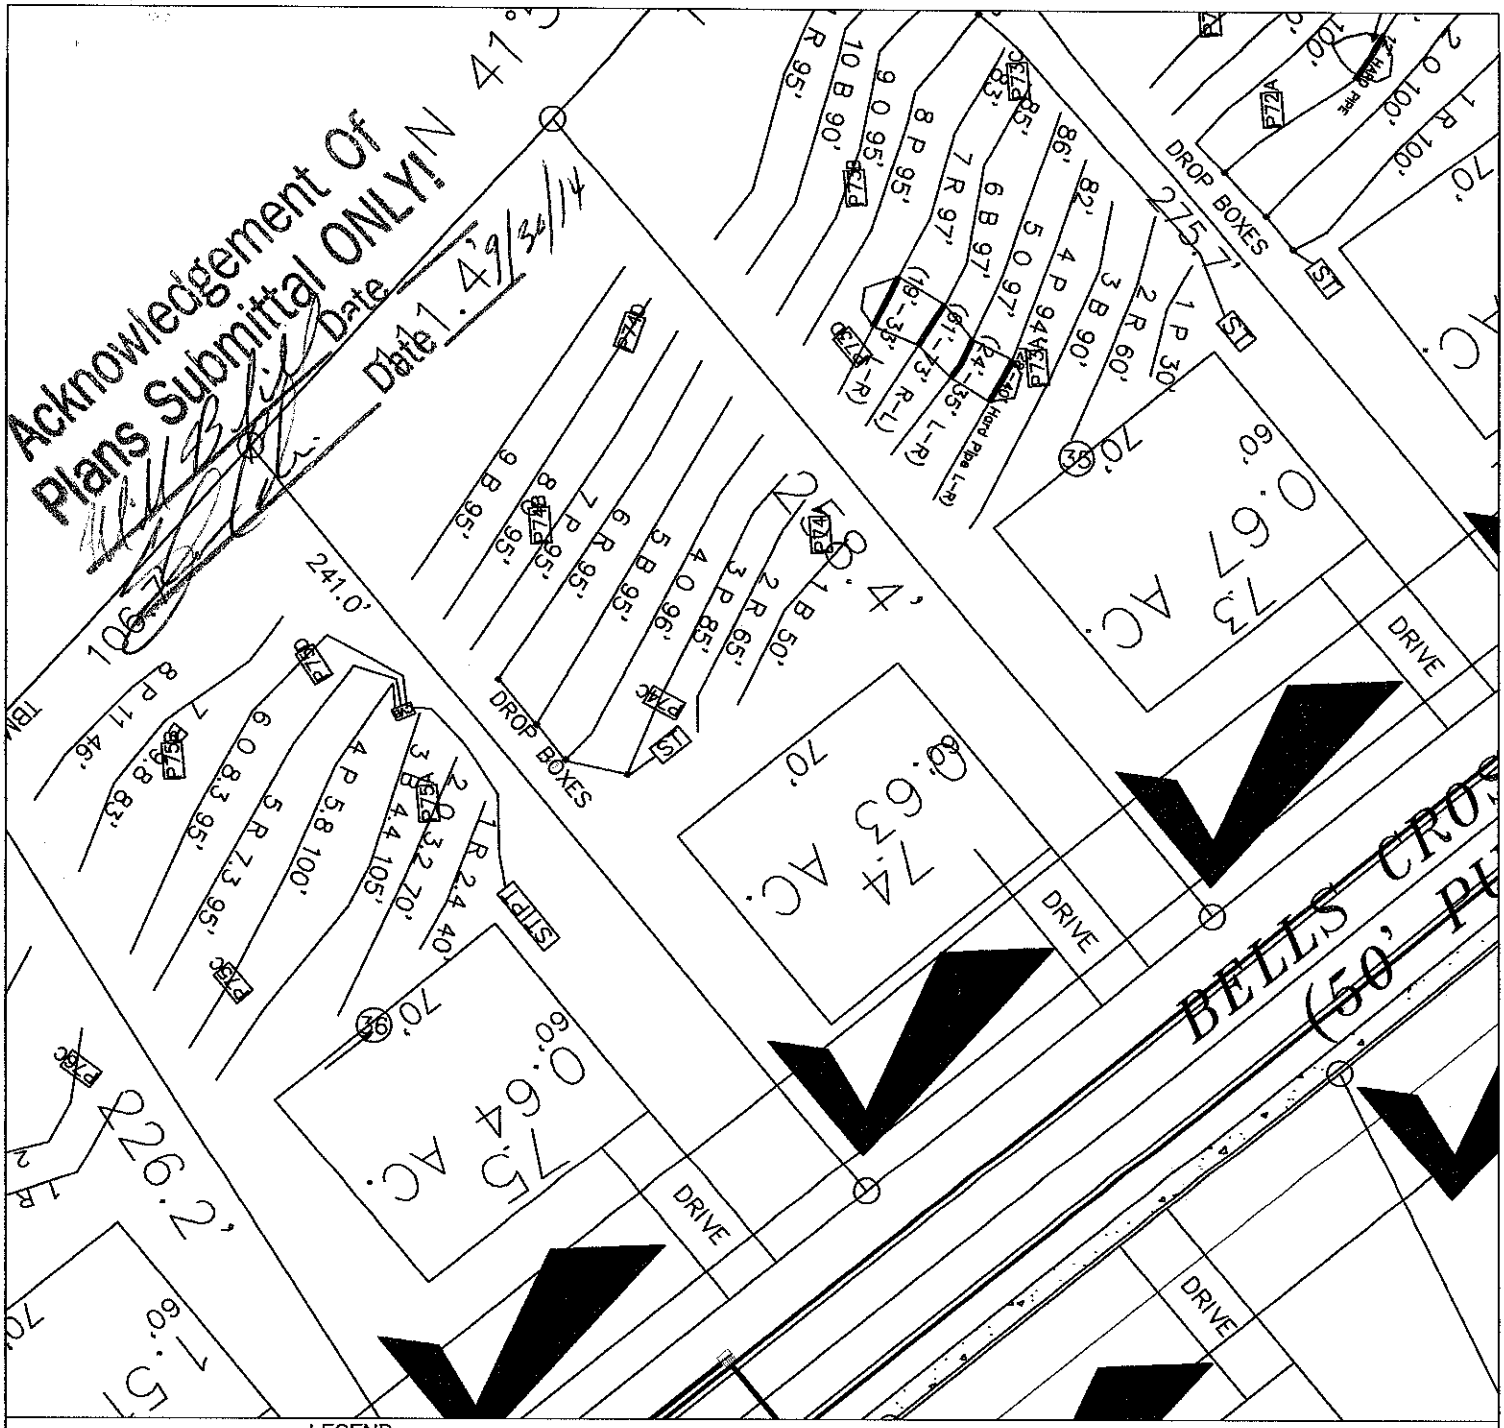

LEGEND

House Box.

System lines.

Repair lines.

GRAPHIC SCALE
1" = 40'

40 0 40 80

FOR PRELIMINARY PLANNING PURPOSES ONLY. ALL LOTS WILL REQUIRE FINAL APPROVAL BY THE COUNTY HEALTH DEPARTMENT ON A LOT BY LOT BASIS. THIS MAP SHOULD BY USED AS A GENERAL GUIDE, SOME ADJUSTMENTS WILL BE NECESSARY IN THE FIELD DUE TO SOIL VARIABILITY AND COMPLEX TOPOGRAPHIC FEATURES.
THIS MAP ONLY REFLECTS EXISTING SOIL SUITABILITY FOR ON-SITE SEPTIC TANK SYSTEMS.

PLEASE REFER TO ATTACHED SOIL REPORT FOR ADDITIONAL SITE SPECIFIC INFORMATION

ROLLANS SOIL & ENVIRONMENTAL SERVICES
PO BOX 832
MOORESVILLE, NC 28115
PHONE: (704) 278-0989
FAX: (704) 278-0989
BRADY FREEMAN, R.S.
MOBILE: (704) 746 - 6497
EMAIL: BFREE0989@YAHOO.COM
ASHLEY ROLLANS, NC LICENSED SOIL SCIENTIST
MOBILE: (704) 746 - 5046
EMAIL: ROLLANS.ASHLEY@YAHOO.COM

MAP TITLE: SITE PLAN & DRAINFIELD AREAS

PROJECT NAME: BELLS CROSSING, LLC / BELLS CROSSING

LOCATION/DATE: PERTH RD IREDELL COUNTY, NORTH CAROLINA NOV 2008

JOB # : 01-1429
FILE: C:\JOBS\01-1429
PROJECT MGR.: C.B.F.
FIELD WORK: C.B.F., A.L.P. & M.D.B.
DRAWN BY: C.B.F. & M.D.B.