IREDELL COUNTY HEALTH DEPARTMENT

STATESVILLE 704-878-5305 MOORESVILLE 704-664-5281

IMPROVEMENT PERMIT / AUTHORIZATION TO CONSTRUCT / OPERATION PERMIT / EXISTING SYSTEM INSPECTION

PERMIT # Repair PIN # 4639749292 DATE 10-18-2012

OWNER or APPLICANT Heather Gerstenkorn PHONE: Business Home:

OWNER or APPLICANT ADDRESS 229 Bells Crossing

LOCATION / DIRECTIONS Perth Rd TL Bay Crossing near end on left

SUBDIVISION Bells Crossing BLOCK / SECTION LOT # 199 LOT AREA DESIGN FLOW 480gpd L.T.A.R. .275

Septic Tank 1000 Gallons: STB 825 Date 8-27-12

Pump Tank Gallons: PT Date

Pump Make Model Serial #

Nitrification Field No Fields No Lines Linear Feet

Trench Width Max. Trench Bottom Depth Existing Gravel Depth

☐ New System ☒ Repair ☐ Expansion System Type I II (III) IV V VI

System Description: 1st only - 25% Reduction

Repair System Description: LPP BPS

Maintenance Agreement Required ☐ YES ☒ NO

☒ GRAVITY ☐ PRESSURE

☒ Residence No. Bedrooms 4

☐ Business No. Persons

☐ Other No. Employees

☐ Slab ☐ Crawl Space

☐ Basement w/plumbing ☐ Basement w/o plumbing


Water Supply: ☐ Private ☐ Public ☒ Community

Comments / Conditions: Replaced top of ST only. Damaged. Checked top & Pre Sealed.


Comments / Conditions

INITIAL SITE SKETCH

Scale 1:40

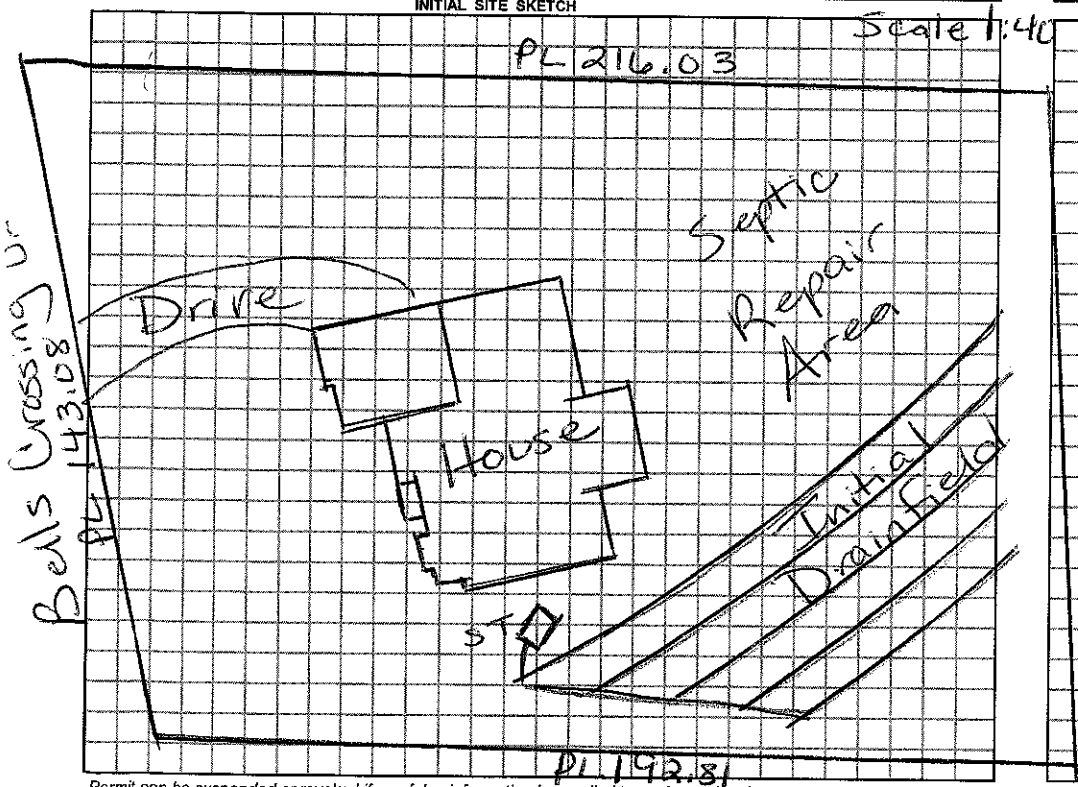

AS BUILT SKETCH

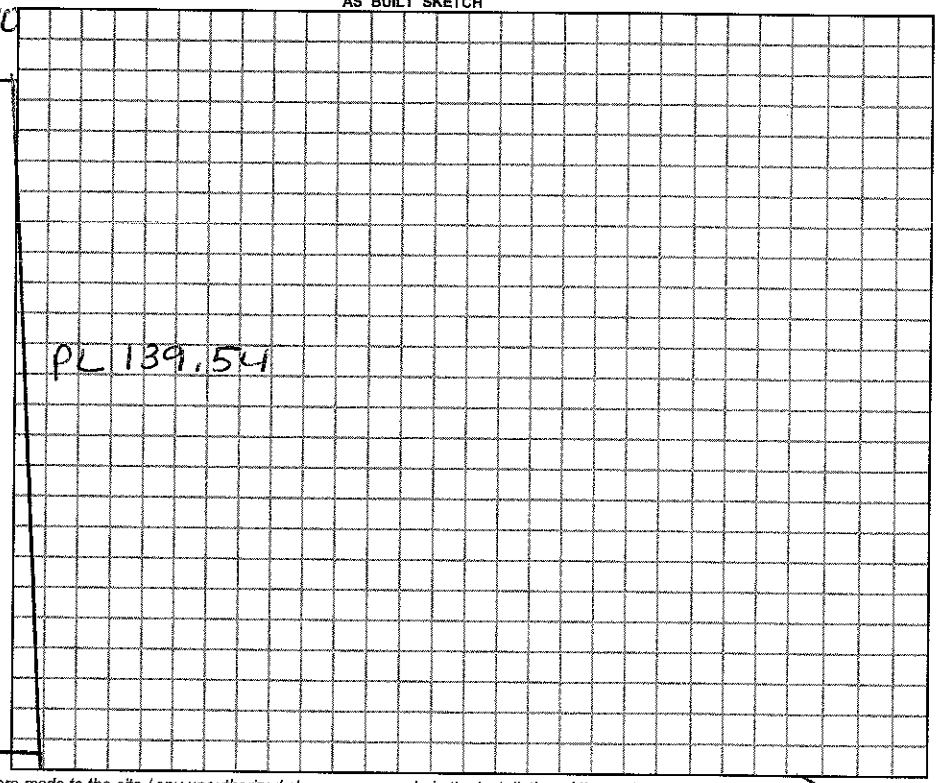

Permit can be suspended or revoked if any false information is supplied toward securing the permit / any unauthorized changes are made to the site / any unauthorized changes are made in the installation of the system.

☐ *IMPROVEMENT PERMIT w / plat valid without expiration.* ☐ *IMPROVEMENT PERMIT w / site plan valid for 60 mos.* ☐ *AUTHORIZATION TO CONSTRUCT valid for period equal to IMPROVEMENT PERMIT-not to exceed 60 mo.*

Owner / Applicant Signature: Date

Improvement Permit by: Date 10/18/12

Authorization to Construct by: Date 10/18/12

Installed by: R&H (ST by Rowan)

Operation Permit by: Date: 10/18/12

Existing System Inspected by: Date:

YOU SHOULD CONTACT A LOCATOR SERVICE PRIOR TO ANY EXCAVATION.

WHITE COPY Environmental Health YELLOW COPY (Final) Owner / Applicant PINK COPY (Initial) Owner / Applicant