IREDELL COUNTY HEALTH DEPARTMENT

STATESVILLE 704-878-5305 MOORESVILLE 704-664-5281

IMPROVEMENT PERMIT / AUTHORIZATION TO CONSTRUCT / OPERATION PERMIT / EXISTING SYSTEM INSPECTION

PERMIT# 152485 PIN# ~~4639-83-4045.073~~ 4639749506 DATE 9-8-08

OWNER OR APPLICANT Bells Crossing LLC PHONE: Business 704-662-1600 Home

ADDRESS 127 B Promenade Dr. Mooresville NC 28117

LOCATION Perth, TL Bells Crossing, on R

SUBDIVISION Bells Crossing BLOCK / SECTION LOT 73 LOT AREA .67Ac SITE CLASS. PS DESIGN FLOW 480 L.T.A.R. .35

Septic Tank: 1000 Gallons: STB 700 Date 7-15

Pump Tank: Gallons: PT Date

Pump Make: Model Serial No.

Nitrification Field: No Fields 1 Square Feet 1125' Linear Feet 375'

No Lines 4 Trench Width 36" Max Trench Bottom Depth 36" Gravel Depth — ☒ Gravity ☐ Pressure

☒ New System ☐ Repair ☐ Expansion System Type: I ☒ III IV V VI

System Description: Gravity 25% Red

Repair System Description: Same

Maintenance Agreement Required: ☐ Yes ☒ No

☒ House/Mod. Home No. Bedrooms 4

☐ Mobile Home No. Persons 8

☐ Business No. Employees

☐ Other


Water Supply: ☐ Individual ☐ Public ☒ Community

☐ Slab ☒ Crawl Space ☐ Basement w/plumbing ☐ Basement wo/plumbing


Comments:/Conditions: 1) Install per plan specs Attached by Rollans Soil + Env. Services 2) Maintain setbacks

Comments:/Conditions: BASEMENT TO BE UNFINISHED. IF BASEMENT IS EVER FINISHED MORE SEPTIC MAY NEED TO BE ADDED

INITIAL SITE SKETCH 1"=40'

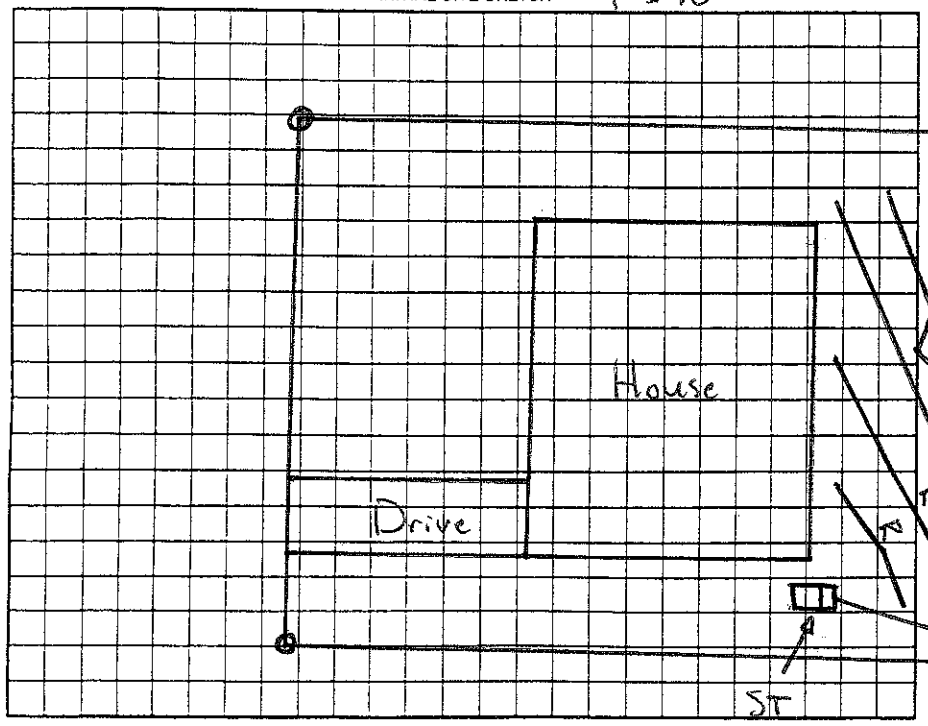

AS BUILT SKETCH

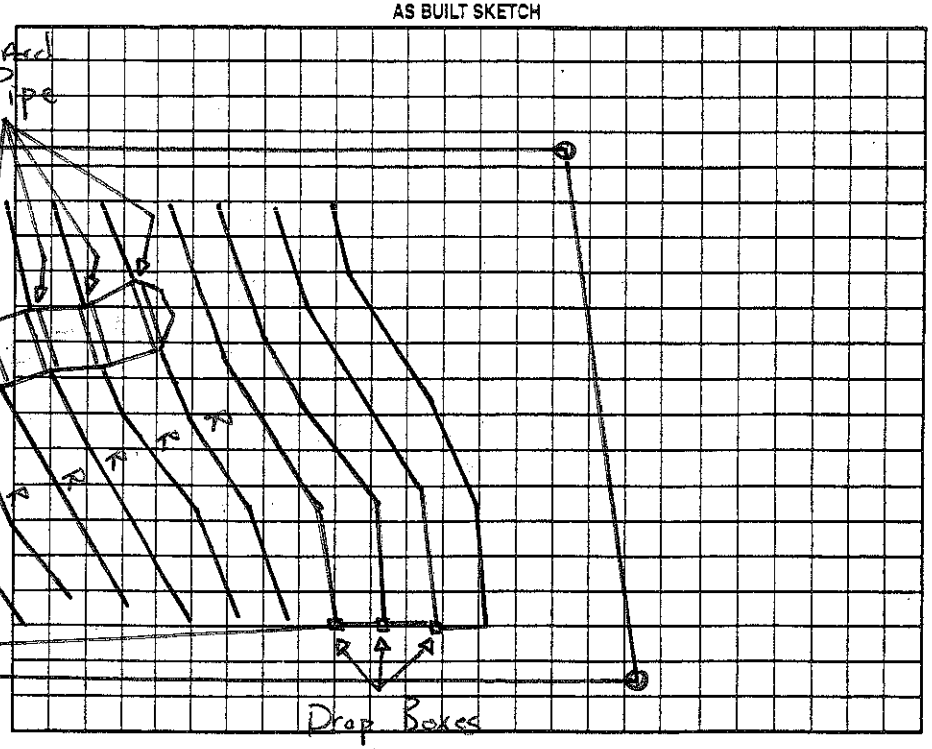

Permit can be suspended or revoked if any false information is supplied toward securing the permit/any unauthorized changes are made to the site/any unauthorized changes are made in the installation of the system. Improvement Permit with plat valid without expiration ☒ Improvement Permit with site plan valid for sixty months ☒ Authorization to Construct is valid for a period equal to that of Improvement Permit – not to exceed sixty months.

Signed: date 7/12/08 Installed by: CPC

Improvement Permit by: date 9-8-08 Operation Permit by: date 11-22-13

Authorization to Construct by: date 7-8-13 Existing System Inspection by: date

HEALTH DEPT. COPY: WHITE OWNER COPY (FINAL): YELLOW OWNER COPY (INITIAL): PINK