IREDELL COUNTY HEALTH DEPARTMENT

STATESVILLE 704-878-5305 MOORESVILLE 704-664-5281

IMPROVEMENT PERMIT / AUTHORIZATION TO CONSTRUCT / OPERATION PERMIT / EXISTING SYSTEM INSPECTIO

PERMIT# 109490 PIN# 4639-85-0633.39 4639756731 DATE March 7, 03

OWNER OR CONTRACTOR Courthian Development PHONE: Business Home

ADDRESS P.O. Box 990 Denver N.C. 28037

LOCATION 150W, TR Forth Road (North) TL Fern Hill TL Creekwood TR Duvat Ct. At end on Right

SUBDIVISION Creekwood Village BLOCK / SECTION 2 LOT 39 LOT AREA .817Ac SITE CLASS. PS DESIGN FLOW 460gpd L.T.A.R. N.25

Septic Tank: 1000 Gallons; STB 786 Date 2/2/03

Pump Tank: 1000 Gallons; PT 49 Date 4/11/03

Pump Make: Model Serial No.

Nitrification Field: No Fields 1 Square Feet 1500 Linear Feet 500

No Lines 5 @ 100' Trench Width 36" Max Trench Bottom Depth 36" Gravel Depth NA

~~New System~~ ☐ Repair System Type: I, II, III, IV, V, VI

System Description: PM - 25% Reduction

Repair System Description: LPP BB

Maintenance Agreement Required: ☐ Yes ☑ No initially

~~House~~/Mod. Home ☐ Mobile Home ☐ Business ☐ Other

No. Bedrooms 4 No. Bathrooms 2 No. Employees


☐ Slab ☑ Crawl Space ☐ Basement w/plumbing ☐ Basement wo/plumbing

Water Supply: ☑ Individual ☐ Public ☐ Community

Comments:/Conditions:

Comments:/Conditions: EZ FLOW INSTALLED.

INITIAL SITE SKETCH 1"=50'

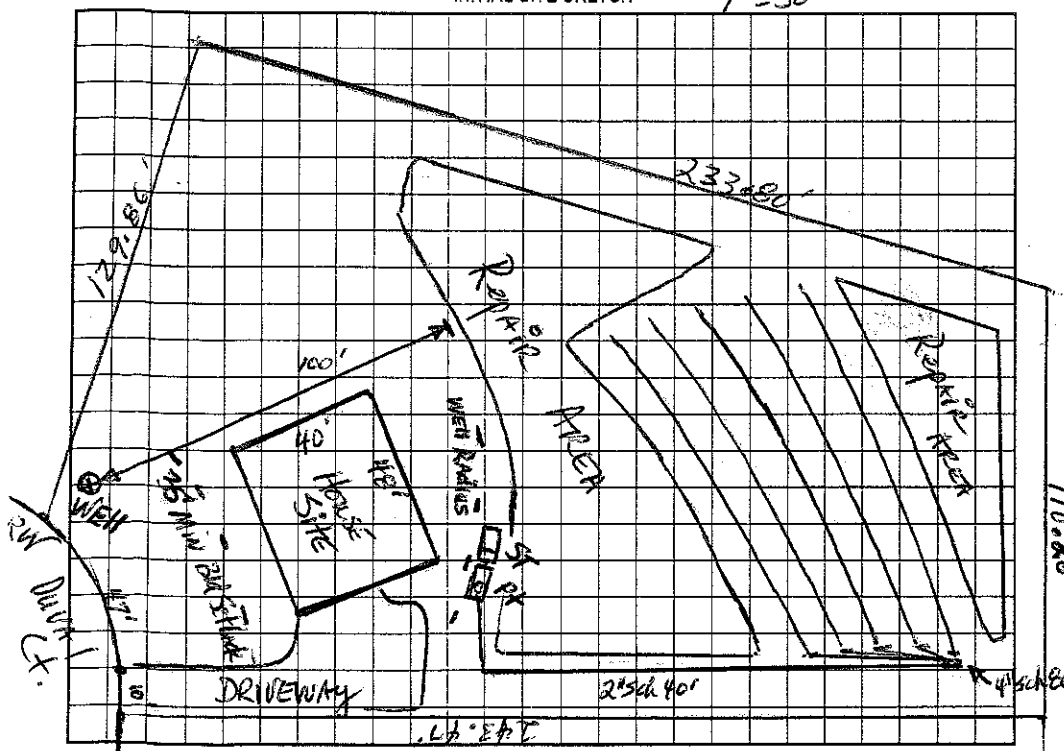

AS BUILT SKETCH

Permit can be suspended or revoked if any false information is supplied toward securing the permit/any unauthorized changes are made to the site/any unauthorized changes are made in the installation of the system. Improvement Permit with plat valid without expiration. Improvement Permit with site plan valid for sixty months. Authorization to Construct is valid for a period equal to that of Improvement Permit – not to exceed sixty months.

Signed: date 3-17-03 Installed by: Courthian Dev

Improvement Permit by: date 3-14-03 Operation Permit by date 8/25/03

Authorization to Construct by: date 3-14-03 Existing System Inspection by: date

HEALTH DEPT. COPY: WHITE OWNER COPY (FINAL): YELLOW OWNER COPY (INITIAL): PINK