IREDELL COUNTY HEALTH DEPARTMENT

STATESVILLE 704-878-5305 MOORESVILLE 704-664-5281

IMPROVEMENT PERMIT / AUTHORIZATION TO CONSTRUCT / OPERATION PERMIT / EXISTING SYSTEM INSPECTION

PERMIT# 106505 PIN# ~~4639-76-8044.13~~ 4639-75-6996 DATE 7/25/02

OWNER OR CONTRACTOR CORINTHIAN DEVELOPMENT PHONE: Business 827-9607 Home

ADDRESS PO Box 990 DENVER NC 28037

LOCATION PERTH RD (NORTH) - TL FERN HILL - TL CREEKWOOD - ON RT

SUBDIVISION CREEKWOOD BLOCK / SECTION LOT 13 LOT AREA .94AC SITE CLASS. PS DESIGN FLOW 360GPD L.T.A.R. 360GPD/RT

Septic Tank: 1000 Gallons; STB 786 Date 4/21/02

Pump Tank: Gallons; PT Date

Pump Make: Model Serial No.

Nitrification Field: No Fields 1 Square Feet 900 Linear Feet 300

No Lines 3@100' Trench Width 36" Max Trench Bottom Depth 36" Gravel Depth

☑ New System ☐ Repair System Type: I, II, III, IV, V, VI

System Description: GRAVITY INNOVATIVE

Repair System Description: SAME

Maintenance Agreement Required: ☐ Yes ☑ No

☑ House/Mod. Home No. Bedrooms 3

☐ Mobile Home No. Bathrooms 3

☐ Business No. Employees

☐ Other


☐ Slab ☑ Crawl Space ☐ Basement w/plumbing ☐ Basement wo/plumbing

Water Supply: ☑ Individual ☐ Public ☐ Community


Comments:/Conditions:

Comments:/Conditions:

INITIAL SITE SKETCH 1" = 50'

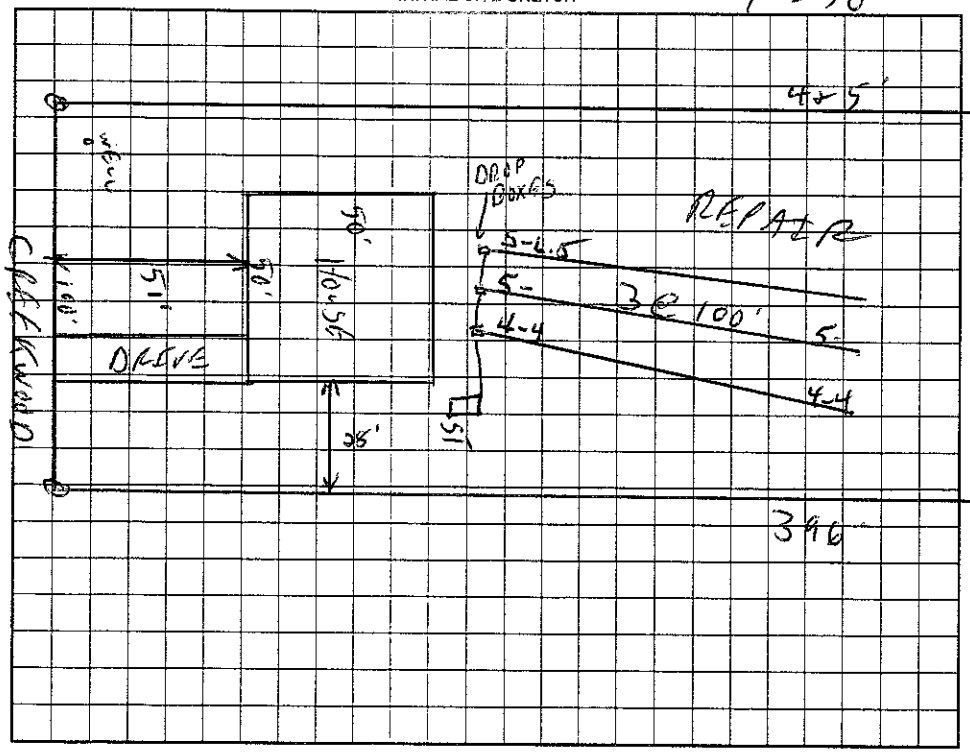

AS BUILT SKETCH

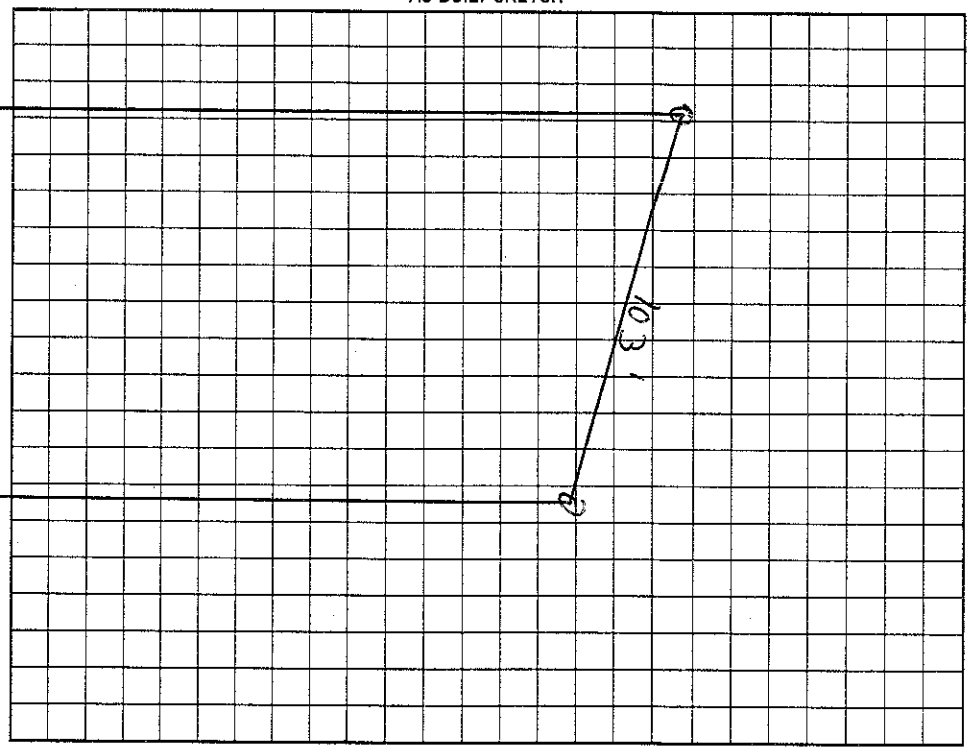

Permit can be suspended or revoked if any false information is supplied toward securing the permit/any unauthorized changes are made to the site/any unauthorized changes are made in the installation of the system. Improvement Permit with plat valid without expiration. Improvement Permit with site plan valid for sixty months. Authorization to Construct is valid for a period equal to that of Improvement Permit – not to exceed sixty months.

Signed: date

Improvement Permit by: RS date 7/25/02

Authorization to Construct by: RS date 7/25/02

Installed by: Corinthian Builders

Operation Permit by: Wesley Sparks RS date 8/12/02

Existing System Inspection by: date

HEALTH DEPT. COPY: WHITE OWNER COPY (FINAL): YELLOW OWNER COPY (INITIAL): PINK