$130

IREDELL COUNTY HEALTH DEPARTMENT

STATESVILLE 704-878-5305 MOORESVILLE 704-664-5281

IMPROVEMENT PERMIT / AUTHORIZATION TO CONSTRUCT / OPERATION PERMIT / EXISTING SYSTEM INSPECTI

PERMIT# 109492 PIN# 4639-85-0633.40 4639757747 DATE Feb 26, 03

OWNER OR CONTRACTOR Corinthian Development/Bldrs. PHONE: Business Home

ADDRESS P.O. Box 990 Denver, N.C. 28037

LOCATION ISDW TR Perth Rd (N) TL Fern Hill TL Creekwood TR Duval on Right near end

SUBDIVISION Creekwood Village BLOCK / SECTION 2 LOT 40 LOT AREA .587 Ac SITE CLASS. PS DESIGN FLOW 360gpd L.T.A.R. .225

Septic Tank: 1000 Gallons; STB 781 Date 11-11-02

Pump Tank: 1000 Gallons; PT 771 Date 12/6/02

Pump Make: Myers Model ME50511 Serial No. 11-11-02

Nitrification Field: No Fields 1 Square Feet 544/816 Linear Feet 272

No Lines 8@34' Trench Width 24"min 8'oc OR 36"max 9'oc Max Trench Bottom Depth 36"

☑ New System ☐ Repair System Type: I II III IV V VI

System Description: 4"sch80 pvc to PPBPS

Repair System Description: PPBPS

Maintenance Agreement Required: ☐ Yes ☑ No initially

Gravel Depth NA

☑ House/Mod. Home No. Bedrooms 3

☐ Mobile Home No. Bathrooms 2

☐ Business No. Employees

☐ Other


☐ Slab ☑ Crawl Space ☐ Basement w/plumbing ☐ Basement wo/plumbing

Water Supply: ☐ Individual ☐ Public ☐ Community

Comments/Conditions: French drain required due to lateral water movement. Install French Drain at 48" depth on REAR AND extend 50' along each side line then use 4" corrugated plastic pipe to daylight along front side of house. OK to use EEE 2½ Flow for French Drain. See ME for Details OR Front Ditch

Comments/Conditions: Pressure test 7/22/03 MB French Drain moved to PL

INITIAL SITE SKETCH

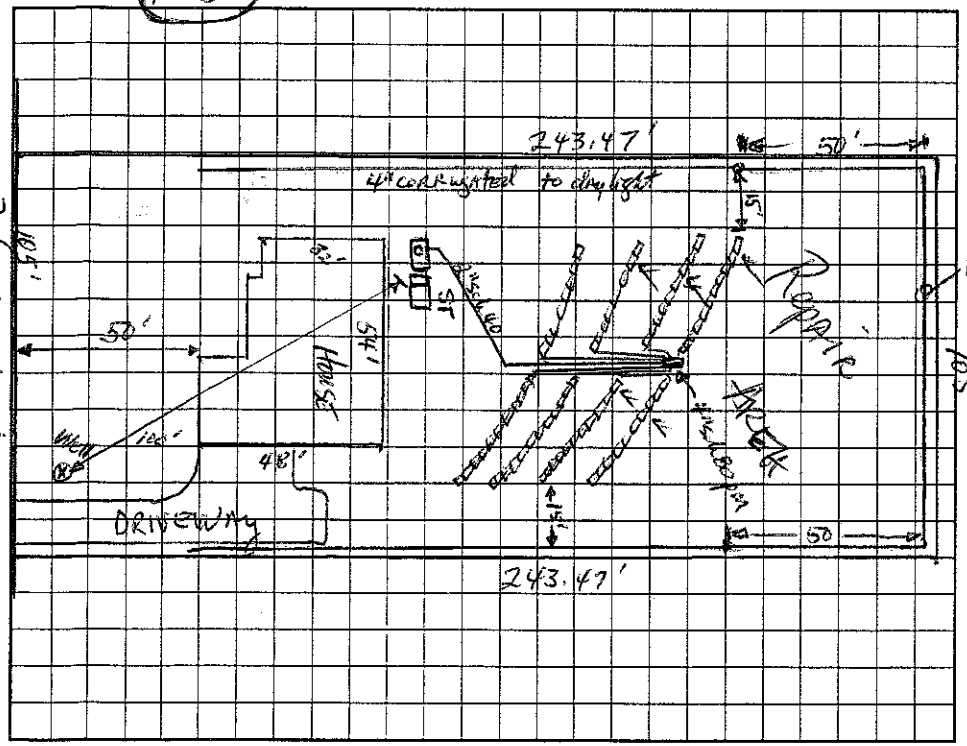

AS BUILT SKETCH

Permit can be suspended or revoked if any false information is supplied toward securing the permit/any unauthorized changes are made to the site/any unauthorized changes are made in the installation of the system. Improvement Permit with plat valid without expiration. Improvement Permit with site plan valid for sixty months. Authorization to Construct is valid for a period equal to that of Improvement Permit – not to exceed sixty months.

Signed: date 2-26-03 Installed by: Corinthian Dev.

Improvement Permit by: Mark K Hanson, RS date 2-26-03 Operation Permit by: RS date 7/30/03

Authorization to Construct by: Mark K Hanson, RS date 2-26-03 Existing System Inspection by: date

HEALTH DEPT. COPY: WHITE OWNER COPY (FINAL): YELLOW OWNER COPY (INITIAL): PINK