IREDELL COUNTY HEALTH DEPARTMENT

STATESVILLE 704-878-5305 MOORESVILLE 704-664-5281

IMPROVEMENT PERMIT / AUTHORIZATION TO CONSTRUCT / OPERATION PERMIT / EXISTING SYSTEM INSPECTION

PERMIT# 109484 PIN# 4639-85-0633.36 4639-75-9035 DATE July 2, 2004

OWNER OR CONTRACTOR Kurt Hudson PHONE: Business _____ Home _____

ADDRESS 113 Duval Court Mocksville 27028

LOCATION Perth Rd. N. TL Fern Hill TL Creekwood Dr. TR Duval Ct. At end on left

SUBDIVISION Creekwood BLOCK / SECTION 2 LOT 36 LOT AREA 5.765 ac SITE CLASS. IS DESIGN FLOW 480 gpd L.T.A.R. .3

Septic Tank: 1000 Gallons; STB 350 Date 2/2/05
Pump Tank: 1000 Gallons; PT 27 Date 3/4/05
Pump Make: _____ Model _____ Serial No. _____
Nitrification Field: No Fields 1 Square Feet 900 Linear Feet 300
No Lines 3@100' Trench Width 36" Max Trench Bottom Depth 36" Gravel Depth NA

☑ New System ☐ Repair System Type: I, II, III, IV, V, VI
System Description: pm 25% Reduction
Repair System Description: pm 25% Reduction
Maintenance Agreement Required: ☐ Yes ☑ No

☑ House/Mod. Home No. Bedrooms 3
☐ Mobile Home No. Bathrooms 2
☐ Business No. Employees _____
☐ Other _____
☐ Slab ☑ Crawl Space ☐ Basement w/plumbing ☐ Basement wo/plumbing


Water Supply: ☑ Individual ☐ Public ☐ Community

Comments:/Conditions:


Comments:/Conditions:
EZ Flow Installed

1"=100'

INITIAL SITE SKETCH

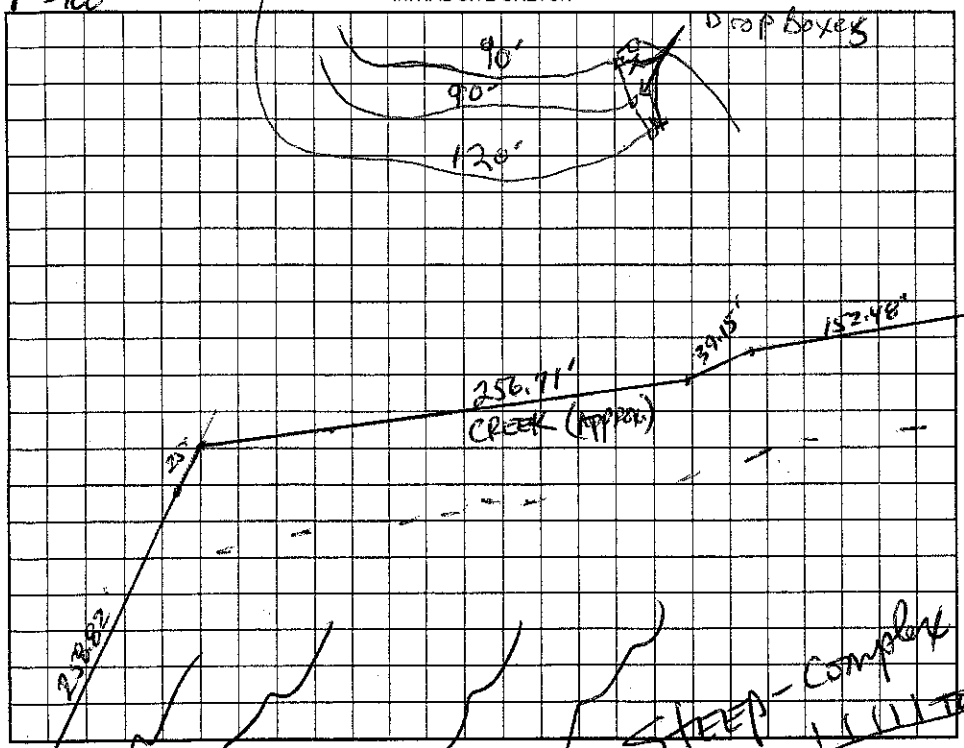

AS BUILT SKETCH

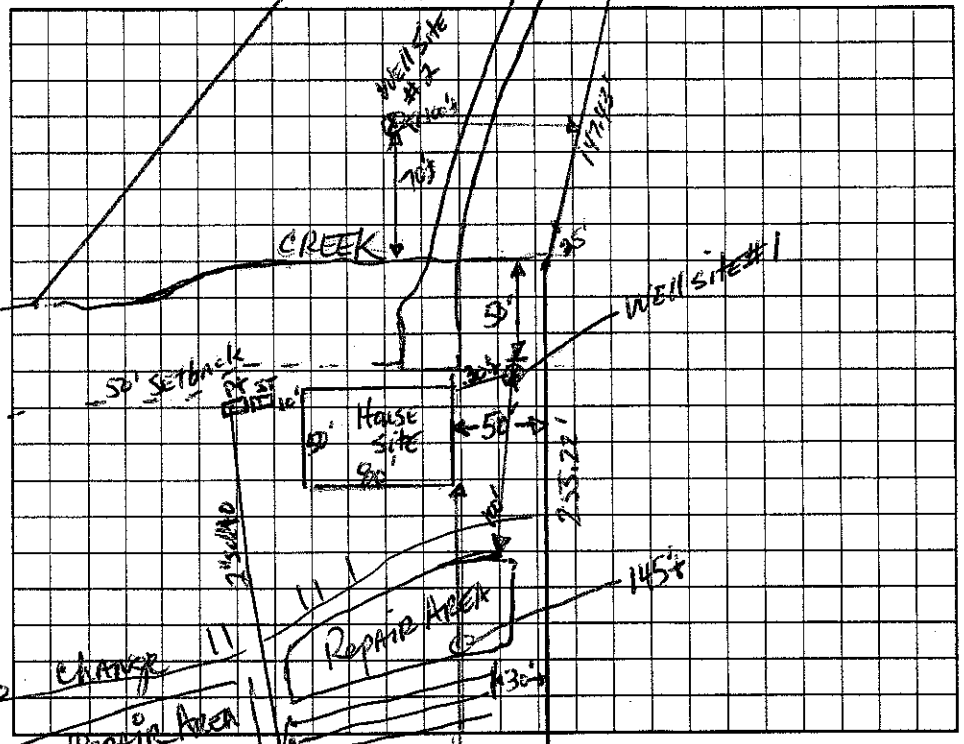

Permit can be suspended or revoked if any false information is supplied toward securing the permit/any unauthorized changes are made to the site/any unauthorized changes are made in the installation of the system. Improvement Permit with plat valid without expiration. Improvement Permit with site plan valid for sixty months. Authorization to Construct is valid for a period equal to that of Improvement Permit – not to exceed sixty months.

Signed: _____ date 7/2/04

Improvement Permit by: _____ date 7-2-04

Authorization to Construct by: _____ date 7-2-04

Installed by: Piedmont Septic

Operation Permit by: _____ date 8/22/06

Existing System Inspection by: _____ date _____

HEALTH DEPT. COPY: WHITE OWNER COPY (FINAL): YELLOW OWNER COPY (INITIAL): PINK