IREDELL COUNTY HEALTH DEPARTMENT

STATESVILLE 704-878-5305 MOORESVILLE 704-664-5281

IMPROVEMENT PERMIT / AUTHORIZATION TO CONSTRUCT / OPERATION PERMIT / EXISTING SYSTEM INSPECTION

130.00 + 9 i &

DATE 5-21-2002

PERMIT# 106292 ZO PIN# ~~4639768044~~ 4639-76-3947 Phil

OWNER OR CONTRACTOR Corinthian Development PHONE: Business 704 400-1258 Home

ADDRESS P.O. Box 990 Denver, NC 28037

LOCATION Hwy 150 West TR Perth Rd TL Fern Hill 1 1/4 on left Creekwood Rd TR

SUBDIVISION Creekwood Village BLOCK / SECTION LOT 23 LOT AREA .61 Acre SITE CLASS. PS DESIGN FLOW 360gpd L.T.A.R. .3

Septic Tank: 1000 Gallons: STB 796 Date 4/16/02

Pump Tank: Gallons: PT Date

Pump Make: Model Serial No.

Nitrification Field: No Fields 1 Square Feet 900' Linear Feet 300'

No Lines 3 @ 100' Trench Width 36" Max Trench Bottom Depth 28" Gravel Depth N/A

[X] New System [ ] Repair System Type: I, II, III, IV, V, VI

System Description: * Gravity - 25% Reduction

Repair System Description: Same

Maintenance Agreement Required: [ ] Yes [X] No

[X] House/Mod. Home [ ] Mobile Home [ ] Business [ ] Other

No. Bedrooms 3 No. Bathrooms 2.5 No. Employees

[ ] Slab [X] Crawl Space [ ] Basement w/plumbing [ ] Basement wo/plumbing

Water Supply: [X] Individual [ ] Public [ ] Community


Comments:/Conditions: Keep Septic System at least 10' from PL & 100' to Well.

Installed 4@75

Comments:/Conditions: * 25% Reduction in Drainfield area (either Plastic Chamber or EZ Flow Drainfield)

(EZ Flow installed)

INITIAL SITE SKETCH Scale 1:50

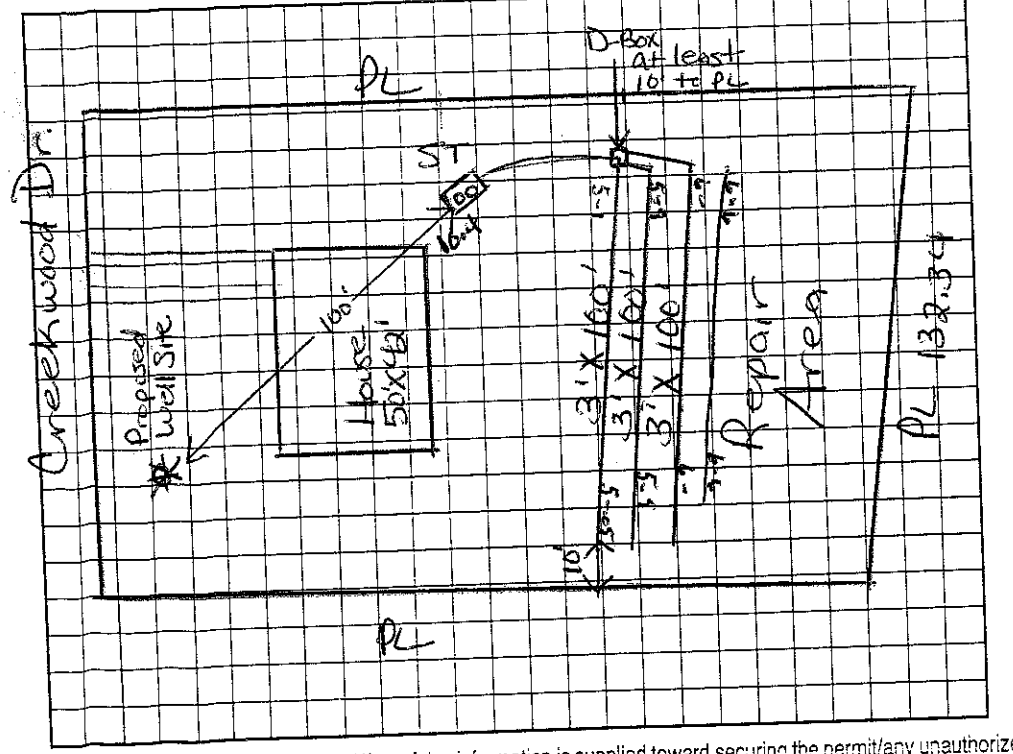

AS BUILT SKETCH

Permit can be suspended or revoked if any false information is supplied toward securing the permit/any unauthorized changes are made to the site/any unauthorized changes are made in the installation of the system. Improvement Permit with plat valid without expiration. Improvement Permit with site plan valid for sixty months. Authorization to Construct is valid for a period equal to that of Improvement Permit – not to exceed sixty months.

Signed: date 5-21-02 Installed by: Phil Schepens - Corinthian Developers.

Improvement Permit by: Maria H. Dotson R.S. date 5/21/2002 Operation Permit by: Wesley Sparks R.S. date 6/20/02

Authorization to Construct by: Maria H. Dotson R.S. date 5/21/2002 Existing System Inspection by: date

HEALTH DEPT. COPY: WHITE OWNER COPY (FINAL): YELLOW OWNER COPY (INITIAL): PINK