IREDELL COUNTY HEALTH DEPARTMENT

STATESVILLE 704-878-5305 MOORESVILLE 704-664-5281

IMPROVEMENT PERMIT / AUTHORIZATION TO CONSTRUCT / OPERATION PERMIT / EXISTING SYSTEM INSPECTIO

PERMIT# 107036 PIN# ~~4639761041.20~~ 4639-76-4645 DATE 9/4/02

OWNER OR CONTRACTOR CORINTHEAN DEV. PHONE: Business 827-9697 Home

ADDRESS PO BOX 990 DENVER NC 28037

LOCATION PERTH (N) - TL FERN HILL - TL CREEKWOOD - ON RT

SUBDIVISION CREEKWOOD VILLAGE BLOCK / SECTION LOT 20 LOT AREA .64C SITE CLASS. V/S DESIGN FLOW 360GPD L.T.A.R. 3610/R2

Septic Tank: 1000 Gallons; STB 55 Date 7/12/02
Pump Tank: Gallons; PT Date
Pump Make: Model Serial No.
Nitrification Field: No Fields 1 Square Feet 900 Linear Feet 300
No Lines 3@100' Trench Width 36" Max Trench Bottom Depth (24") Gravel Depth N/A

☑ New System ☐ Repair System Type: I, II, (III), IV, V, VI
System Description: GRAVITY INNOVATIVE
Repair System Description: SAME
Maintenance Agreement Required: ☐ Yes ☑ No


☑ House/Mod. Home No. Bedrooms 3
☐ Mobile Home No. Bathrooms 3
☐ Business No. Employees
☐ Other
☐ Slab ☑ Crawl Space ☐ Basement w/plumbing ☐ Basement wo/plumbing

Water Supply: ☑ Individual ☐ Public ☐ Community


Comments:/Conditions: 1) DRIVE EITHER SIDE

Comments:/Conditions: EZ LAY INSTALLED

INITIAL SITE SKETCH 1"=50'

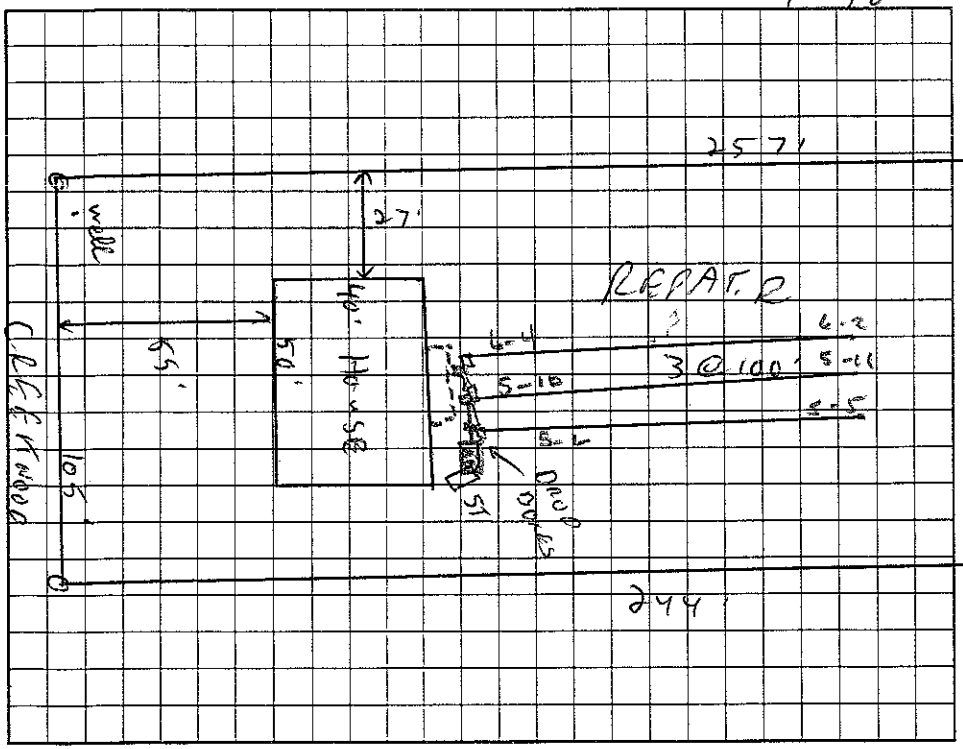

AS BUILT SKETCH

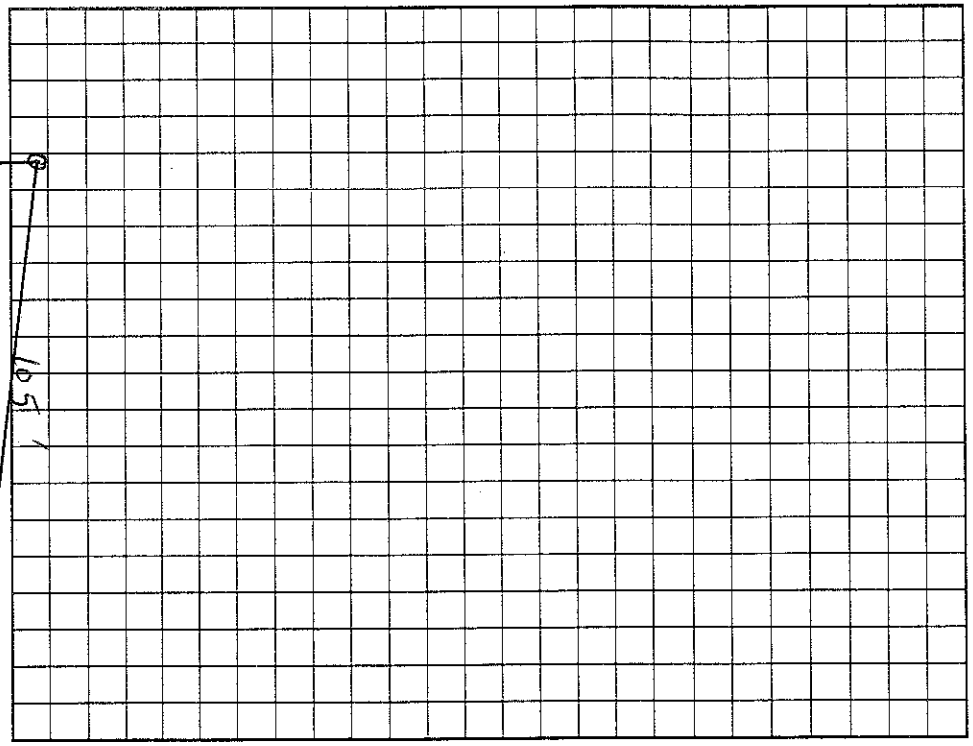

Permit can be suspended or revoked if any false information is supplied toward securing the permit/any unauthorized changes are made to the site/any unauthorized changes are made in the installation of the system. Improvement Permit with plat valid without expiration. Improvement Permit with site plan valid for sixty months. Authorization to Construct is valid for a period equal to that of Improvement Permit – not to exceed sixty months.

Signed: date

Improvement Permit by: C. Smith RS date 9/4/02

Authorization to Construct by: C. Smith RS date 9/4/02

Installed by: Corinthean Dev.

Operation Permit by: Wesley Sparks RS. date 10/7/02

Existing System Inspection by: date

HEALTH DEPT. COPY: WHITE OWNER COPY (FINAL): YELLOW OWNER COPY (INITIAL): PINK