IREDELL COUNTY HEALTH DEPARTMENT

STATESVILLE 704-878-5305 MOORESVILLE 704-664-528

IMPROVEMENT PERMIT / AUTHORIZATION TO CONSTRUCT / OPERATION PERMIT / EXISTING SYSTEM IN

PERMIT# 107035 PIN# ~~4639-76-8041.21~~ 4639-76-4715 DATE 11

OWNER OR CONTRACTOR Corinthian Development PHONE: Business 887-9647 Home

ADDRESS PO Box 990 Denver, NC. 28037 126 Creekwood

LOCATION North N TL Fern Hill TL Creekwood to 4th lot on (R)

SUBDIVISION Creekwood Village BLOCK / SECTION LOT 21 LOT AREA .58Ac SITE CLASS PS DESIGN FLOW 360 L.T.A.R. .3

Septic Tank: 1000 Gallons; STB 786 Date 6/17/02

Pump Tank: Gallons; PT Date

Pump Make: Model Serial No.

Nitrification Field: No Fields 1 Square Feet 900 Linear Feet 300

No Lines 3 @ 100' Trench Width 3' Max Trench Bottom Depth 3 Gravel Depth No

[X] New System [ ] Repair System Type: I, II, (III), IV, V, VI

System Description: GRAVITY - 25% Reduced

Repair System Description: SAME

Maintenance Agreement Required: [ ] Yes [X] No

[X] House/Mod. Home No. Bedrooms 3

[ ] Mobile Home No. Bathrooms 3

[ ] Business No. Employees

[ ] Other

[ ] Slab [X] Crawl Space [ ] Basement w/plumbing [ ] Basement wo/plumbing


Water: [X] Individ. [ ] Public [ ] Commun.

Comments:/Conditions:


Comments:/Conditions:

(1"=30')

~~INITIAL SITE SKETCH~~ AS BUILT SKETCH

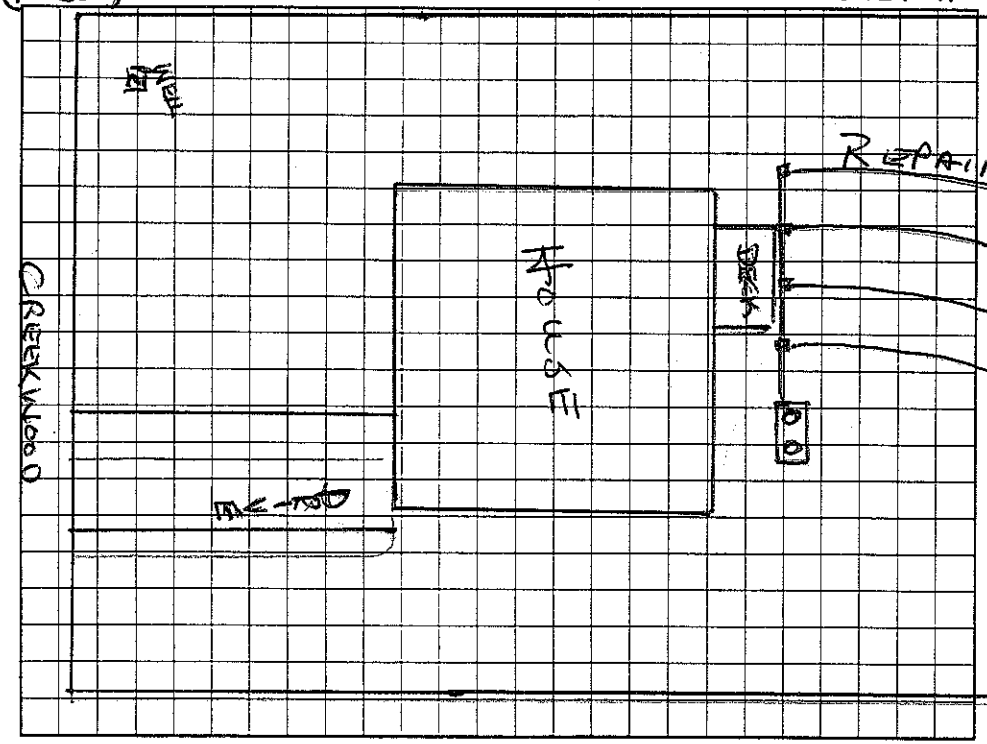

AS BUILT SKETCH

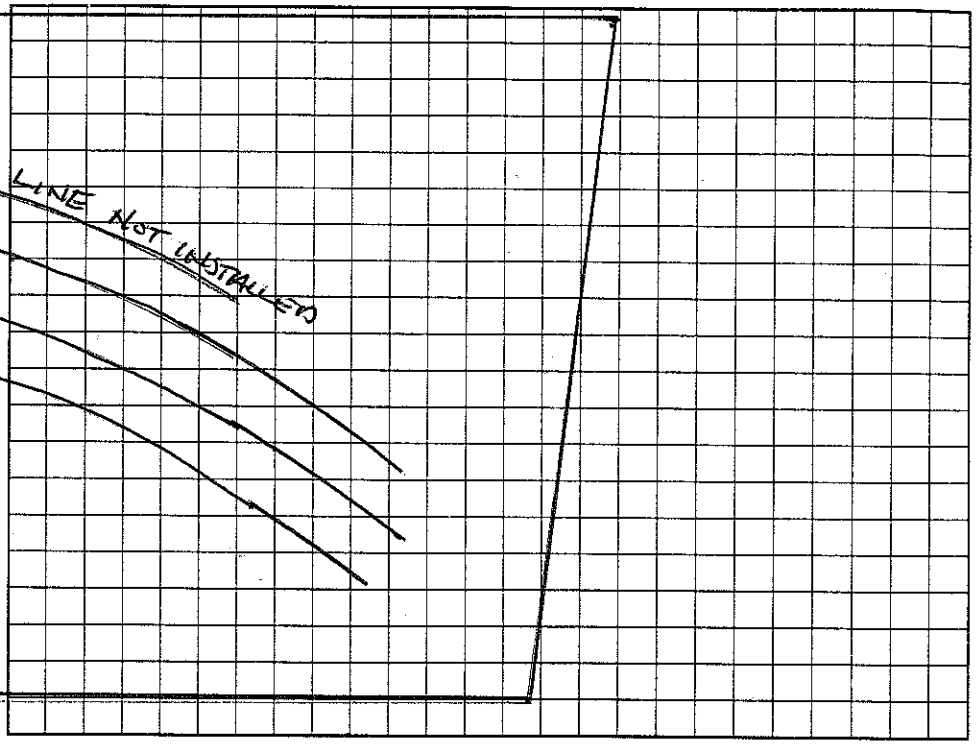

Permit can be suspended or revoked if any false information is supplied toward securing the permit/any unauthorized changes are made to the site/any unauthorized changes are made in the installation of the system. Improvement Permit with plat valid without expiration. Improvement Permit with site plan valid for sixty months. Authorization to Construct is valid for a period equal to that of Improvement Permit – not to exceed sixty months.

Signed: date

Improvement Permit by: CBF date

Authorization to Construct by: CBF date

Installed by: Corinthian Development.

Operation Permit by: Wesley Sparkes date 11/18/02

Existing System Inspection by: date

HEALTH DEPT. COPY: WHITE OWNER COPY (FINAL): YELLOW OWNER COPY (INITIAL): PINK