IREDELL COUNTY HEALTH DEPARTMENT

STATESVILLE 704-878-5305 130.00 Paid MOORESVILLE 704-664-5281

IMPROVEMENT PERMIT / AUTHORIZATION TO CONSTRUCT / OPERATION PERMIT / EXISTING SYSTEM INSPECTION

PERMIT# 107035 PIN# 4639 76 8041. 21 DATE 9/16/02

OWNER OR CONTRACTOR CORINTHIAN DEVELOPMENT PHONE: Business 887-9697 Home

ADDRESS PO BOX 990 DENVER NC 28037 #126 Creekwood

LOCATION PERTH RD (N) - TL FERNHILL - TL CREEKWOOD - ON CT

SUBDIVISION CREEKWOOD VILLAGE BLOCK / SECTION LOT 21 LOT AREA .584C SITE CLASS. PS DESIGN FLOW 360GPD L.T.A.R. .36 GPD/SQ FT

Septic Tank: 1000 Gallons; STB 786 Date 6/17/02

Pump Tank: Gallons; PT Date

Pump Make: Model Serial No.

Nitrification Field: No Fields 1 Square Feet 900 Linear Feet 300

No Lines 4@75' Trench Width 36" Max Trench Bottom Depth 36" Gravel Depth N/A

☑ New System ☐ Repair System Type: I, II, III, IV, V, VI

System Description: GRAVITY INNOVATIVE

Repair System Description: SAME

Maintenance Agreement Required: ☐ Yes ☑ No

☑ House/Mod. Home ☐ Mobile Home ☐ Business ☐ Other

No. Bedrooms 3 No. Bathrooms 3 No. Employees


Water Supply: ☑ Individual ☐ Public ☐ Community

☐ Slab ☑ Crawl Space ☐ Basement w/plumbing ☐ Basement wo/plumbing

Comments:/Conditions: 1) DRIVE ON EITHER SIDE

Comments:/Conditions: EZ LAY INSTALLED

INITIAL SITE SKETCH 1" = 50'

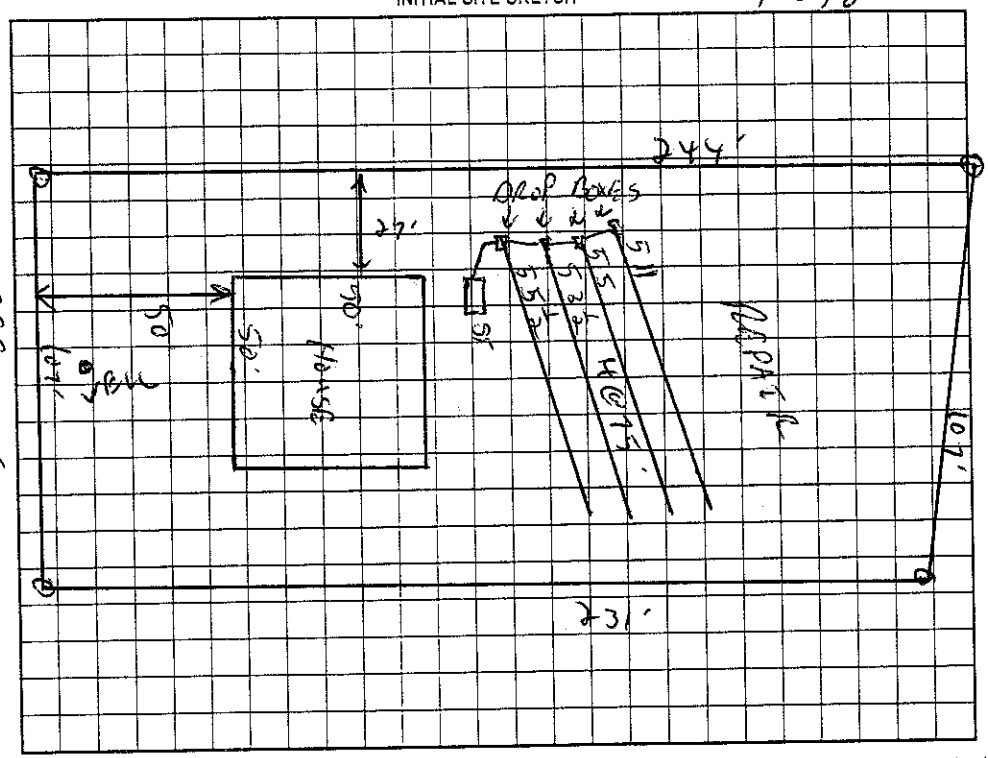

AS BUILT SKETCH

Permit can be suspended or revoked if any false information is supplied toward securing the permit/any unauthorized changes are made to the site/any unauthorized changes are made in the installation of the system. Improvement Permit with plat valid without expiration. Improvement Permit with site plan valid for sixty months. Authorization to Construct is valid for a period equal to that of Improvement Permit – not to exceed sixty months.

Signed: date 9-16- Installed by: Corinthian Development

Improvement Permit by: C. Hyatt RS date 9/16/02 Operation Permit by: Wesley Sparks RS. date 11/15/02

Authorization to Construct by: C. Hyatt RS date 9/16/02 Existing System Inspection by: date

HEALTH DEPT. COPY: WHITE OWNER COPY (FINAL): YELLOW OWNER COPY (INITIAL): PINK