IREDELL COUNTY HEALTH DEPARTMENT

STATESVILLE 704-878-5305 MOORESVILLE 704-664-5281

IMPROVEMENT PERMIT / AUTHORIZATION TO CONSTRUCT / OPERATION PERMIT / EXISTING SYSTEM INSPECTION

PERMIT# 107057 PIN# ~~4639 765041.76~~ 4639-96-5284 DATE 7/25/02

OWNER OR CONTRACTOR CORINTHIAN DEVELOPMENT PHONE: Business 827-4697 Home

ADDRESS PO Box 990 DENVER NC 28037

LOCATION PERTH RD (NORTH) - TL FERN HILL - TL CREEKWOOD - ON RT

SUBDIVISION CREEKWOOD BLOCK / SECTION LOT 16 LOT AREA .78AC SITE CLASS. PS DESIGN FLOW 360GPD L.T.A.R. .25 gal/sq ft

Septic Tank: 1000 Gallons; STB 786 Date

Pump Tank: Gallons; PT Date

Pump Make: Model Serial No.

Nitrification Field: No Fields 1 Square Feet ~~600~~ 1080 Linear Feet 360

No Lines 5@72' Trench Width 36" Max Trench Bottom Depth 36" Gravel Depth N/A

☒ New System ☐ Repair System Type: I, II, (III) IV, V, VI

System Description: GRAVITY INNOVATIVE

Repair System Description: SAME

Maintenance Agreement Required: ☐ Yes ☒ No

☒ House/Mod. Home No. Bedrooms 3

☐ Mobile Home No. Bathrooms 3

☐ Business No. Employees

☐ Other


☐ Slab ☒ Crawl Space ☐ Basement w/plumbing ☐ Basement wo/plumbing

Water Supply: ☒ Individual ☐ Public ☐ Community


Comments:/Conditions:

Comments:/Conditions:

INITIAL SITE SKETCH 1"=50'

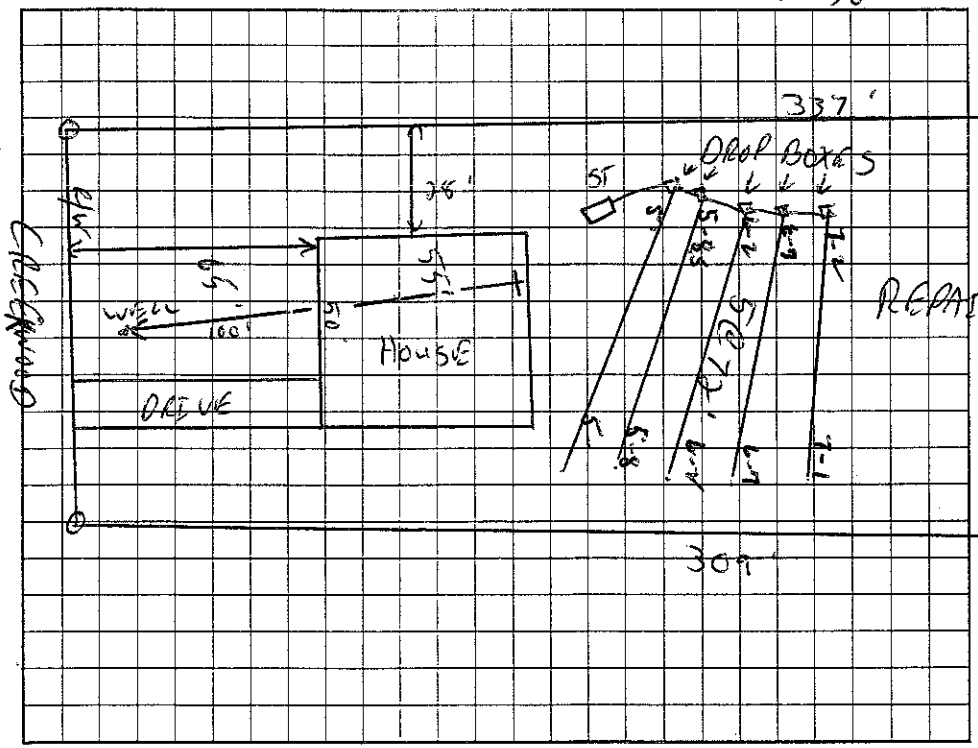

AS BUILT SKETCH

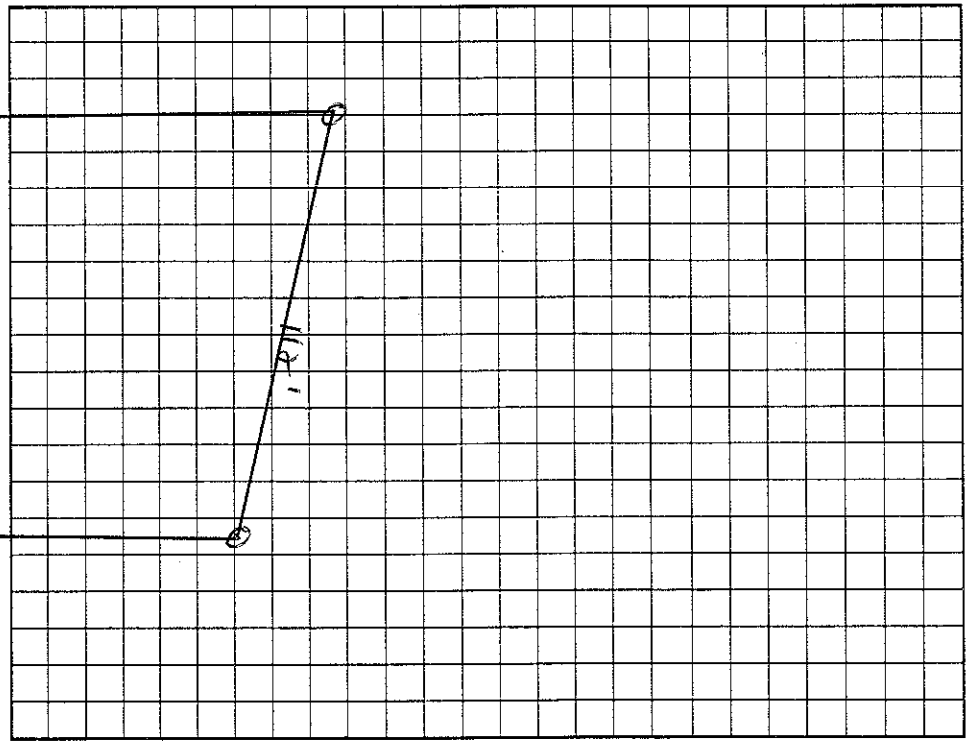

Permit can be suspended or revoked if any false information is supplied toward securing the permit/any unauthorized changes are made to the site/any unauthorized changes are made in the installation of the system. Improvement Permit with plat valid without expiration. Improvement Permit with site plan valid for sixty months. Authorization to Construct is valid for a period equal to that of Improvement Permit – not to exceed sixty months.

Signed: date Installed by: Corinthian Bldrs.

Improvement Permit by: C. [illegible] RS date 7/25/02 Operation Permit by: Wesley Sparks R.S. date 8/13/02

Authorization to Construct by: C. [illegible] RS date 7/25/02 Existing System Inspection by: date

HEALTH DEPT. COPY: WHITE OWNER COPY (FINAL): YELLOW OWNER COPY (INITIAL): PINK