IREDELL COUNTY HEALTH DEPARTMENT

STATESVILLE 704-878-5305 MOORESVILLE 704-664-5281

IMPROVEMENT PERMIT / AUTHORIZATION TO CONSTRUCT / OPERATION PERMIT / EXISTING SYSTEM INSPECTION

PERMIT# 107058 PIN# ~~4639476047.74~~ 4639-76-6065 DATE 9/4/02

OWNER OR CONTRACTOR CORINTHIAN DEVELOPMENT PHONE: Business 400-1058 Home

ADDRESS PO BOX 990 DENVER NC 28037

LOCATION PERTH (N) - TL FERN HILL - TL CREEKWOOD - ON RT

SUBDIVISION CREEKWOOD VILLAGE BLOCK / SECTION LOT 14 LOT AREA .88AC SITE CLASS. RS DESIGN FLOW 450GPD L.T.A.R. .3000/K-10

Septic Tank: 1000 Gallons; STB 736 Date 7/12/02

Pump Tank: Gallons; PT Date

Pump Make: Model Serial No.

Nitrification Field: No Fields 1 Square Feet 1200 Linear Feet 400

No Lines 5@80' Trench Width 36" Max Trench Bottom Depth 36" Gravel Depth N/A

☑ New System ☐ Repair System Type: I, II, (III), IV, V, VI

System Description: GRAVITY INNOVATIVE

Repair System Description: SAME FOOTPRINT

Maintenance Agreement Required: ☐ Yes ☑ No

☑ House/Mod. Home No. Bedrooms 4

☐ Mobile Home No. Bathrooms 4

☐ Business No. Employees

☐ Other

☐ Slab ☑ Crawl Space ☐ Basement w/plumbing ☐ Basement wo/plumbing


Water Supply: ☑ Individual ☐ Public ☐ Community

Comments:/Conditions: 1) DRIVE EITHER SIDE


Comments:/Conditions:

EZ Lay Installed

INITIAL SITE SKETCH

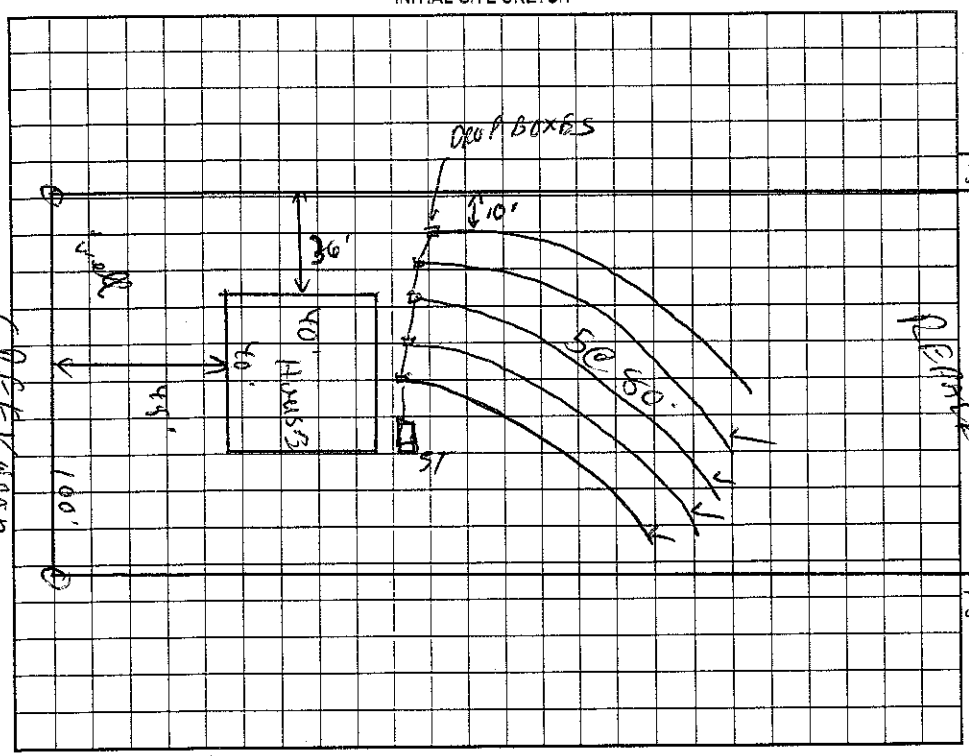

AS BUILT SKETCH

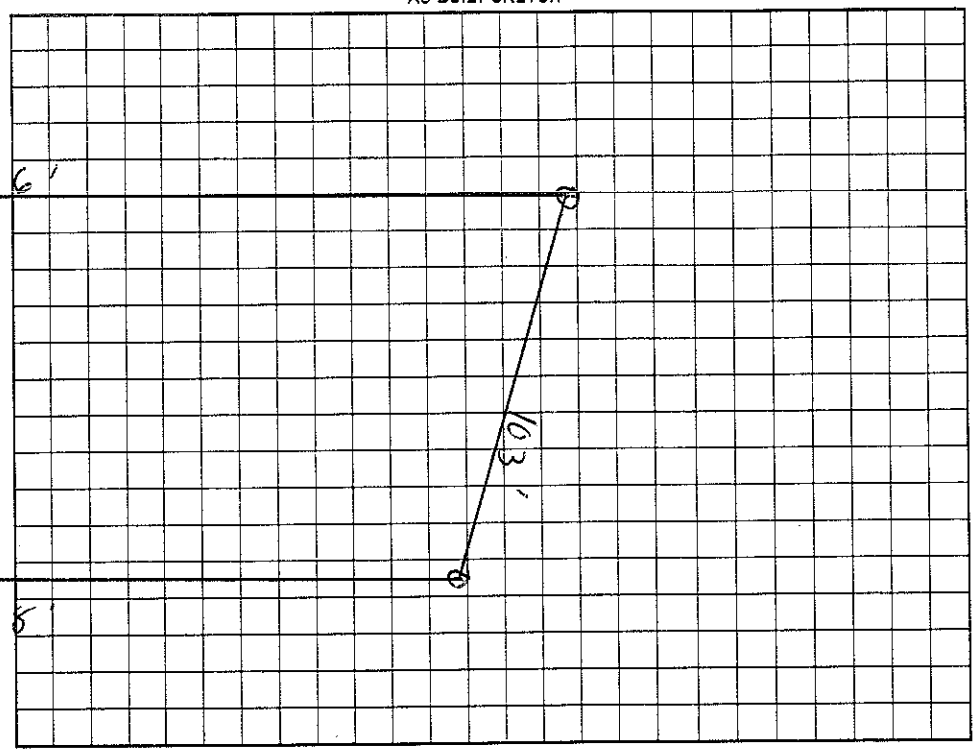

Permit can be suspended or revoked if any false information is supplied toward securing the permit/any unauthorized changes are made to the site/any unauthorized changes are made in the installation of the system. Improvement Permit with plat valid without expiration. Improvement Permit with site plan valid for sixty months. Authorization to Construct is valid for a period equal to that of Improvement Permit – not to exceed sixty months.

Signed: date

Improvement Permit by: C. [illegible] RS date 9/4/02

Authorization to Construct by: C. [illegible] RS date 9/4/02

Installed by: Corinthian Development

Operation Permit by: Wesley Sparks RS. date 10/7/02

Existing System Inspection by: date

HEALTH DEPT. COPY: WHITE OWNER COPY (FINAL): YELLOW OWNER COPY (INITIAL): PINK