IREDELL COUNTY HEALTH DEPARTMENT

STATESVILLE 704-878-5305 130.00 Pd MOORESVILLE 704-664-5281

IMPROVEMENT PERMIT / AUTHORIZATION TO CONSTRUCT / OPERATION PERMIT / EXISTING SYSTEM INSPECTION

PERMIT# 121295 PIN# 4639 76 6125 DATE 7/14/04

OWNER OR CONTRACTOR Timothy Blackhawk PHONE: Business 764-660-0342 Home

ADDRESS 37 Woodstock Ln. Brockport NY 14420

LOCATION Perth N to Farm Hill Rd. to Creekwood Ln. on (R)

SUBDIVISION Creekwood Village BLOCK / SECTION LOT 15 LOT AREA .85 SITE CLASS PS DESIGN FLOW 480 L.T.A.R. .3

Septic Tank: 1000 Gallons; STB 825 Date 9/14/04
Pump Tank: Gallons; PT Date
Pump Make: Model 510/840 Serial No. 280
Nitrification Field: No Fields 1 Square Feet ~~600~~ Linear Feet ~~600~~
No Lines 4 Trench Width 2-3 Max Trench Bottom Depth 3'

☒ New System ☐ Repair System Type: I, II, III, IV, V, VI
System Description: Conventional - 16" PPBPS
Repair System Description: Same
Maintenance Agreement Required: ☐ Yes ☒ No
Gravel Depth No

☒ House/Mod. Home ☐ Mobile Home ☐ Business ☐ Other
No. Bedrooms 4 No. Bathrooms 3 No. Employees
☐ Slab ☒ Crawl Space ☐ Basement w/plumbing ☐ Basement wo/plumbing


Water Supply: ☒ Individual ☐ Public ☐ Community

Comments:/Conditions:


Comments:/Conditions:

(1" = 50')

INITIAL SITE SKETCH

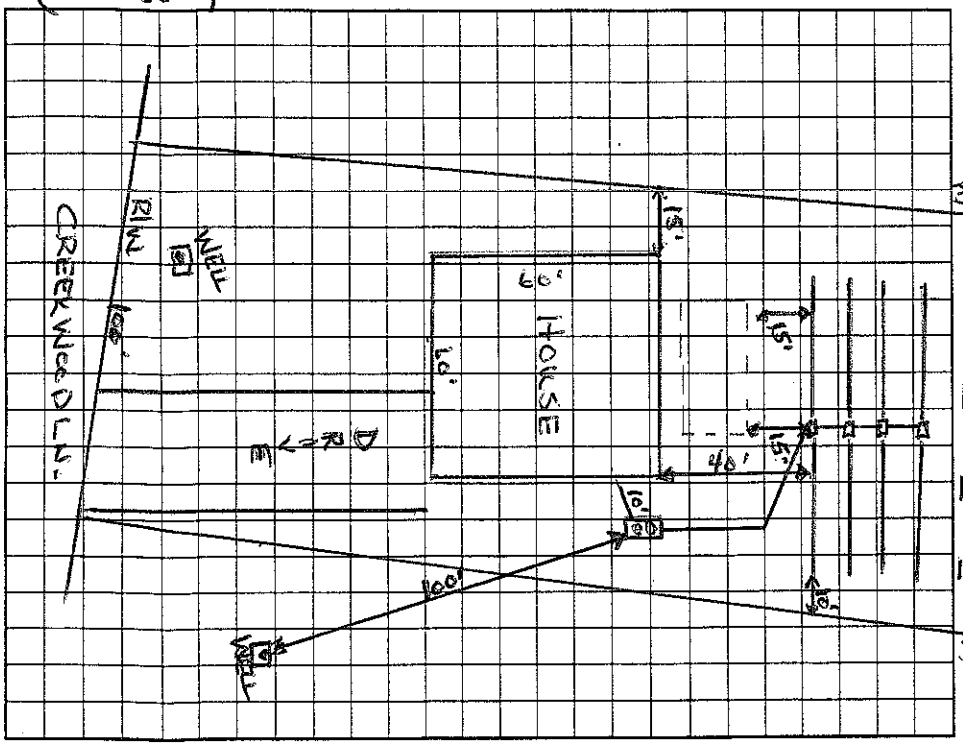

AS BUILT SKETCH

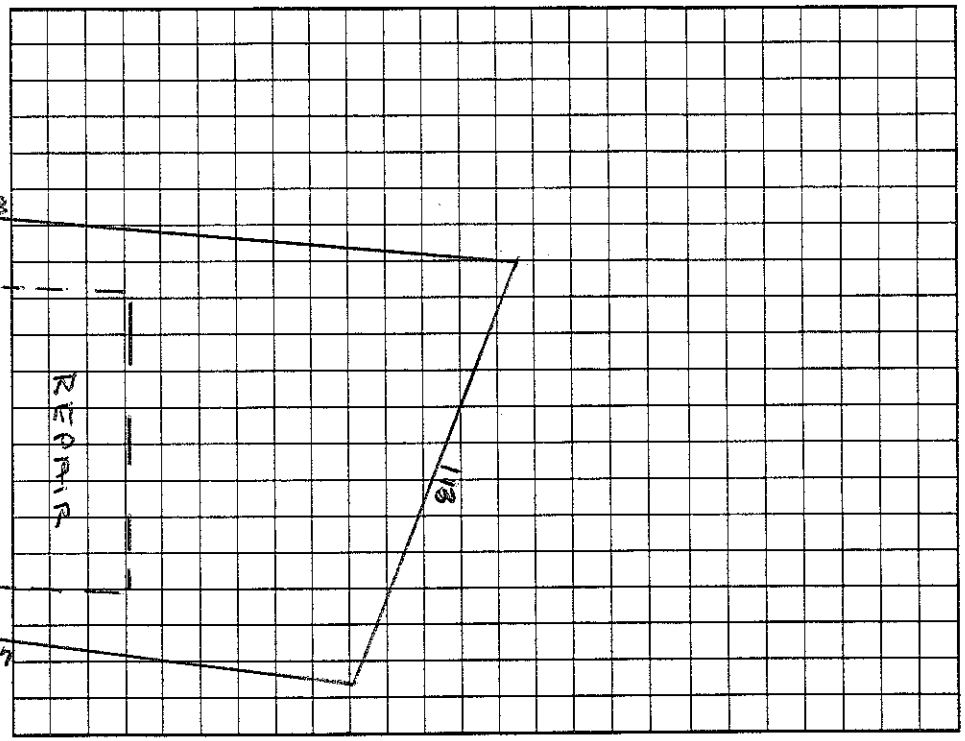

Permit can be suspended or revoked if any false information is supplied toward securing the permit/any unauthorized changes are made to the site/any unauthorized changes are made in the installation of the system. Improvement Permit with plat valid without expiration. Improvement Permit with site plan valid for sixty months. Authorization to Construct is valid for a period equal to that of Improvement Permit – not to exceed sixty months.

Signed: *Lisa Church date 7-16-04 Installed by: Joe Perkins

Improvement Permit by: Wesley Sparks RS date 7/14/04 Operation Permit by: Wesley Sparks RS date 12/14/04

Authorization to Construct by: Wesley Sparks RS date 7/14/04 Existing System Inspection by: date

HEALTH DEPT. COPY: WHITE OWNER COPY (FINAL): YELLOW OWNER COPY (INITIAL): PINK