IREDELL COUNTY HEALTH DEPARTMENT

STATESVILLE 704-878-5305 130.00 Paid MOORESVILLE 704-664-5281

IMPROVEMENT PERMIT / AUTHORIZATION TO CONSTRUCT / OPERATION PERMIT / EXISTING SYSTEM INSPECTION

PERMIT# ~~10650~~ 107015 PIN# ~~4639 76 5041.4~~ 4639-76-6869 DATE 6/10/02

OWNER OR CONTRACTOR CORINTHIAN DEVELOPMENT PHONE: Business 527-9697 Home

ADDRESS PO Box 990 ~~DENVER~~ DENVER NC 28037

LOCATION PERTH(W) - TL FERN HELL (TOWARD LAKE) - TL CREEKWOOD DR. - 4th ON LT

SUBDIVISION CREEKWOOD VILLAGE BLOCK / SECTION LOT 4 LOT AREA .59AC SITE CLASS. PS DESIGN FLOW 360GPD L.T.A.R. .256 AC/FT

Septic Tank: 1000 Gallons; STB 786 Date 6/5/02
Pump Tank: Gallons; PT Date
Pump Make: Model Serial No.
Nitrification Field: No Fields 1 Square Feet 1080 Linear Feet 360
No Lines 5@72' Trench Width 36" Max Trench Bottom Depth 36" Gravel Depth N/A

☑ New System ☐ Repair System Type: I, II, (III), IV, V, VI
System Description: GRAVITY 25% REDUCTION
Repair System Description: LP PANEL
Maintenance Agreement Required: ☐ Yes ☑ No

☑ House/Mod. Home ☐ Mobile Home ☐ Business ☐ Other
No. Bedrooms 3 No. Bathrooms 3 No. Employees


☐ Slab ☑ Crawl Space ☐ Basement w/plumbing ☐ Basement wo/plumbing

Water Supply: ☑ Individual ☐ Public ☐ Community


Comments/Conditions:

Comments:/Conditions:
System was rained in - Trenches Re-dug and Ez-Flow installed.

INITIAL SITE SKETCH 1" = 50'

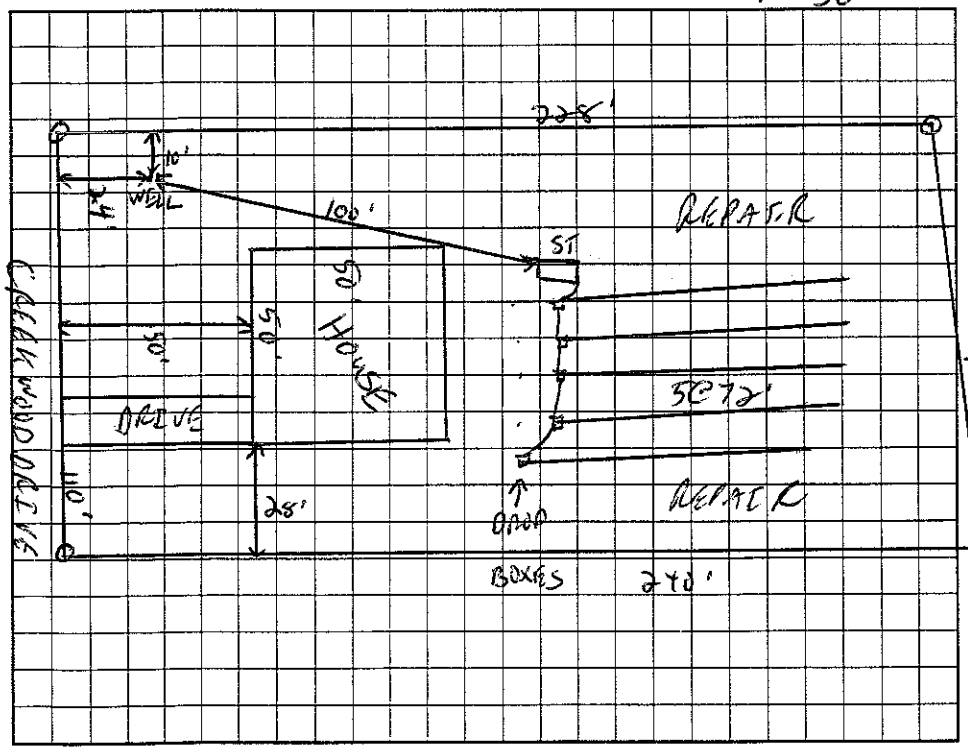

AS BUILT SKETCH

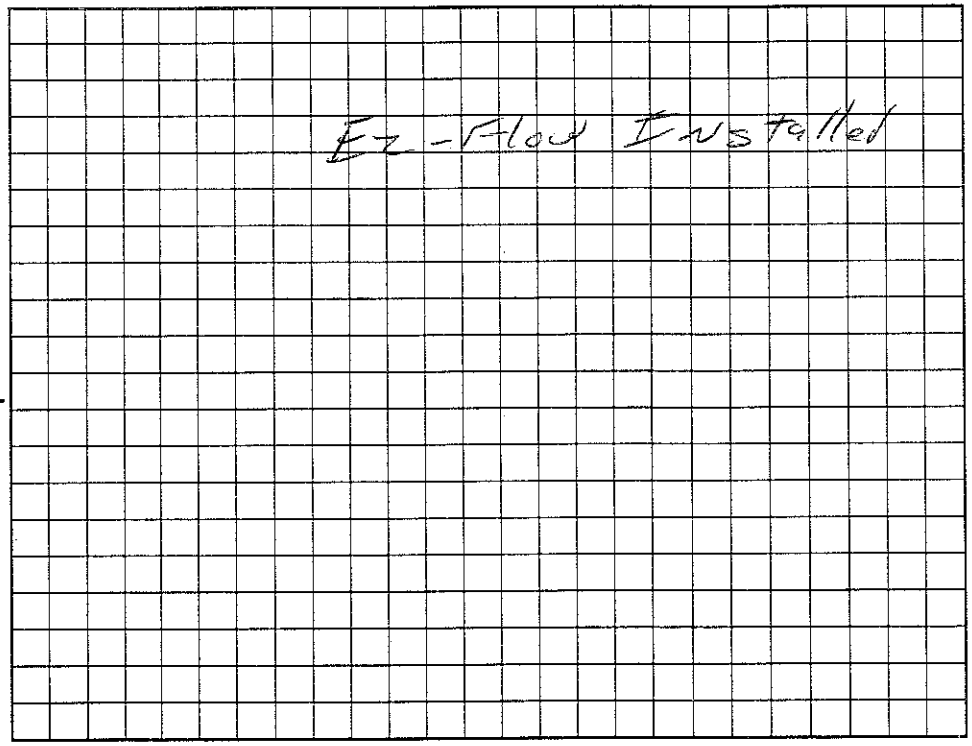

Permit can be suspended or revoked if any false information is supplied toward securing the permit/any unauthorized changes are made to the site/any unauthorized changes are made in the installation of the system. Improvement Permit with plat valid without expiration. Improvement Permit with site plan valid for sixty months. Authorization to Construct is valid for a period equal to that of Improvement Permit – not to exceed sixty months.

Signed: date

Improvement Permit by: C. Day RS date 6/10/02

Authorization to Construct by: C. Day RS date 9/16/02

Installed by: Corinthian Dev. Co.

Operation Permit by: RS date 11/15/02

Existing System Inspection by: date

HEALTH DEPT. COPY: WHITE OWNER COPY (FINAL): YELLOW OWNER COPY (INITIAL): PINK