IREDELL COUNTY HEALTH DEPARTMENT

STATESVILLE 704-878-5305 130.00 Paid MOORESVILLE 704-664-5281

IMPROVEMENT PERMIT / AUTHORIZATION TO CONSTRUCT / OPERATION PERMIT / EXISTING SYSTEM INSPECTION

PERMIT# 107018 PIN# 4639 76 8041.6 4639767740 DATE 10/28/02

OWNER OR CONTRACTOR CORINTHIAN DEVELOPMENT PHONE: Business 527-4697 Home

ADDRESS PO BOX 990 DENVER NC 28037 135

LOCATION PERTH RD - TL FERN HILL - TL CREEKWOOD - ON LT.

SUBDIVISION CREEKWOOD VILLAGE BLOCK / SECTION 1 LOT 6 LOT AREA .6AC SITE CLASS. RS DESIGN FLOW 480GPD L.T.A.R. .259 gpd/sf

Septic Tank: 1000 Gallons; STB Date

Pump Tank: 1000 Gallons; PT Date

Pump Make: Model Serial No.

Nitrification Field: No Fields 1 Square Feet 644 Linear Feet 322

No Lines 7@46' Trench Width 24" Max Trench Bottom Depth 36" Gravel Depth N/A

☑ New System ☐ Repair System Type: I, II, III, IV, V, VI

System Description: PUMP PANEL

Repair System Description: SAME LOW PRESSURE

Maintenance Agreement Required: ☐ Yes ☑ No

☑ House/Mod. Home No. Bedrooms 4

☐ Mobile Home No. Bathrooms 4

☐ Business No. Employees

☐ Other


☐ Slab ☑ Crawl Space ☐ Basement w/plumbing ☐ Basement wo/plumbing

Water Supply: ☑ Individual ☐ Public ☑ Community


Comments:/Conditions:

Comments:/Conditions: EZ FLOW INSTALLED.

INITIAL SITE SKETCH 1" = 50'

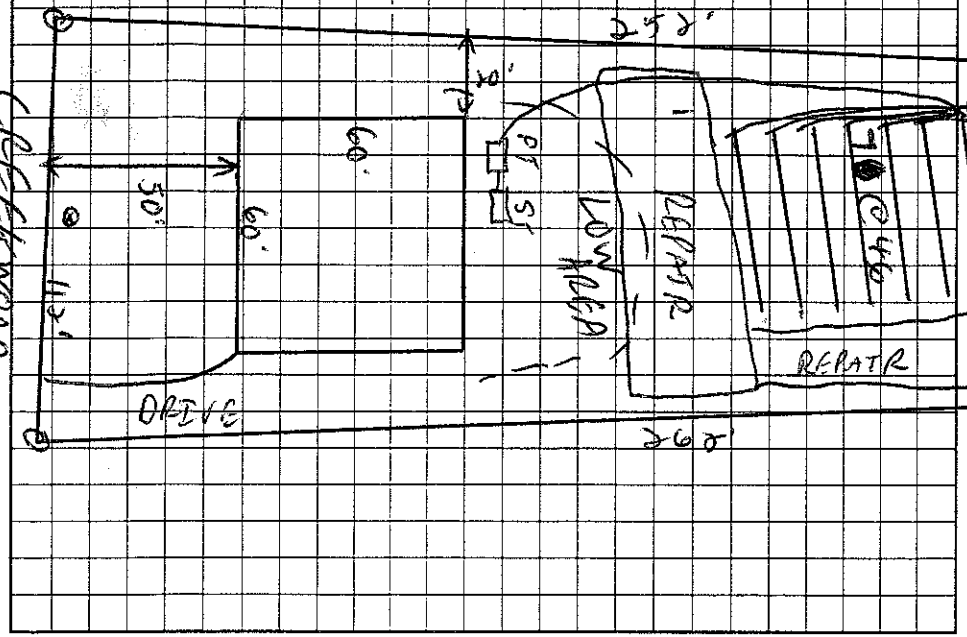

AS BUILT SKETCH

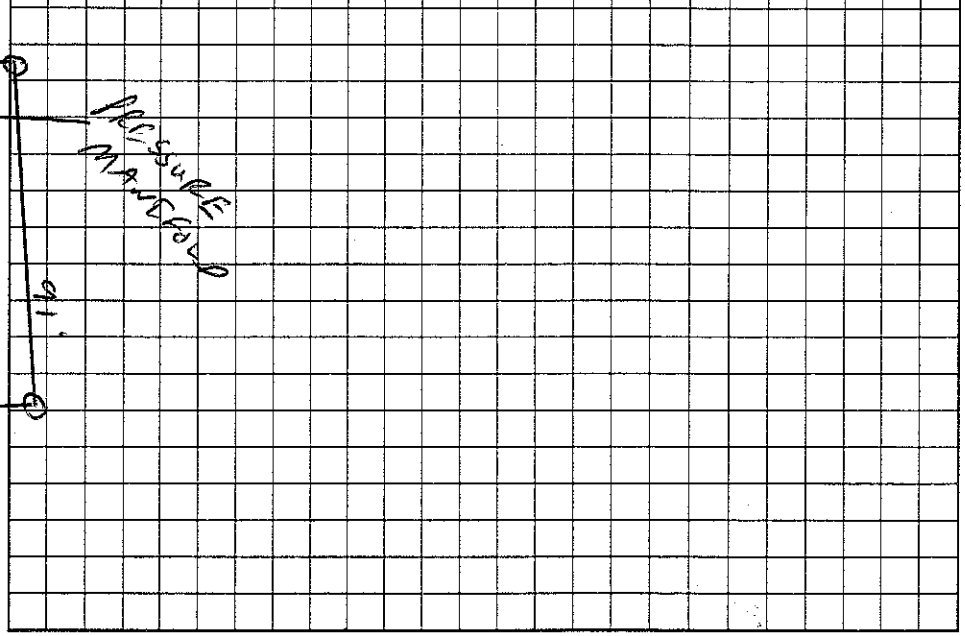

Permit can be suspended or revoked if any false information is supplied toward securing the permit/any unauthorized changes are made to the site/any unauthorized changes are made in the installation of the system. Improvement Permit with plat valid without expiration. Improvement Permit with site plan valid for sixty months. Authorization to Construct is valid for a period equal to that of Improvement Permit – not to exceed sixty months.

Signed: date 10-28- Installed by: Corinthian Development

Improvement Permit by: RS date 10/28/02 Operation Permit by: Wesley Sparks RS. date 3/4/03

Authorization to Construct by: RS date 10/30/02 Existing System Inspection by: date

HEALTH DEPT. COPY: WHITE OWNER COPY (FINAL): YELLOW OWNER COPY (INITIAL): PINK