IREDELL COUNTY HEALTH DEPARTMENT

STATESVILLE 704-878-5305 130.00 Paid MOORESVILLE 704-664-5281

IMPROVEMENT PERMIT / AUTHORIZATION TO CONSTRUCT / OPERATION PERMIT / EXISTING SYSTEM INSPECTION

PERMIT# 107030 PIN# 4639 76 8041 . 8 4639768532 DATE 11/27/02

OWNER OR CONTRACTOR CORINTHIAN DEV. PHONE: Business 827-9697 Home

ADDRESS PO BOX 990 DENVER NC 28037

LOCATION PERTH RD - OFF (N) - TL FERN HILL - TL CREEKWOOD ON LT.

SUBDIVISION CREEKWOOD VILLAGE BLOCK / SECTION 1 LOT 8 LOT AREA .66AC SITE CLASS. RS DESIGN FLOW 360GPD L.T.A.R. .3600/RF

Septic Tank: 1000 Gallons; STB 786 Date 9/17/02
Pump Tank: 1000 Gallons; PT 313 Date 11/8/02
Pump Make: MYERS Model R7W Serial No.
Nitrification Field: No Fields 1 Square Feet 900 Linear Feet 300
No Lines 3@100' Trench Width 36" Max Trench Bottom Depth 36" Gravel Depth N/A

☑ New System ☐ Repair System Type: I, II, (III), IV, V, VI
System Description: PUMP INNOVATIVE
Repair System Description: SAME
Maintenance Agreement Required: ☐ Yes ☑ No


☑ House/Mod. Home No. Bedrooms 3
☐ Mobile Home No. Bathrooms 3
☐ Business No. Employees
☐ Other
☐ Slab ☑ Crawl Space ☐ Basement w/plumbing ☐ Basement wo/plumbing

Water Supply: ☑ Individual ☐ Public ☐ Community


Comments:/Conditions:

Comments:/Conditions:

INITIAL SITE SKETCH 1"=50'

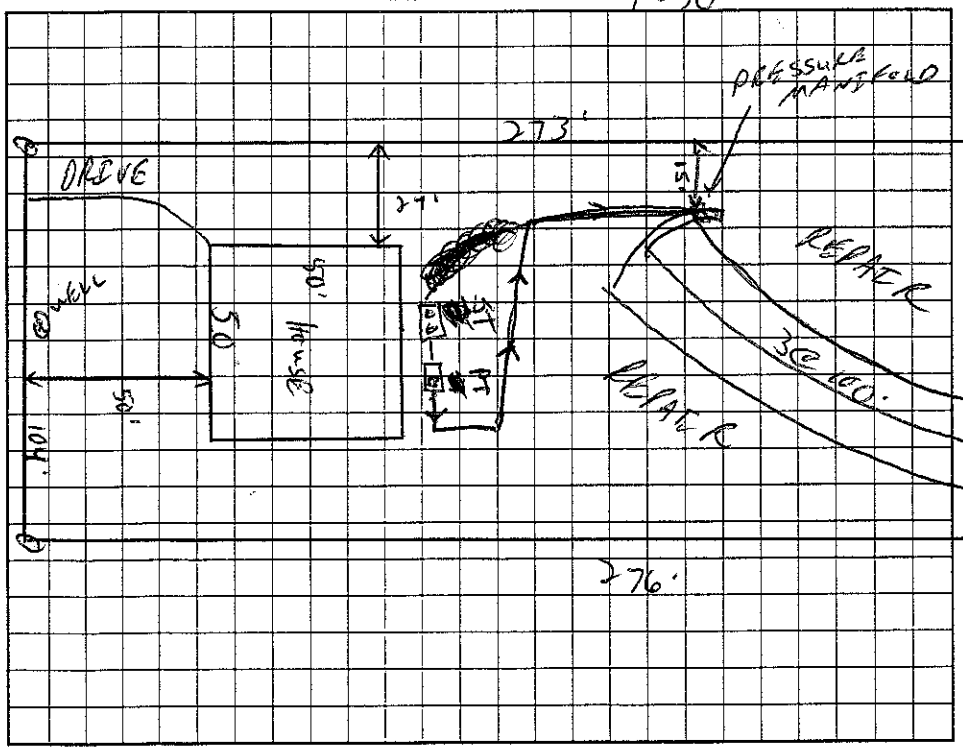

AS BUILT SKETCH

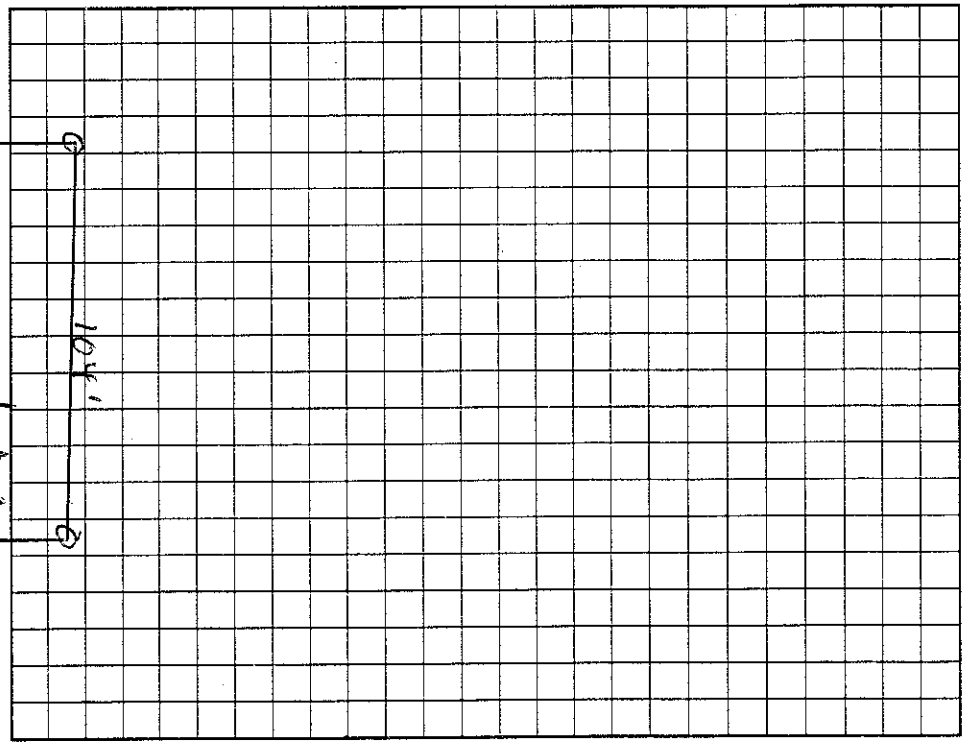

CREEKWOOD DRIVE

Permit can be suspended or revoked if any false information is supplied toward securing the permit/any unauthorized changes are made to the site/any unauthorized changes are made in the installation of the system. Improvement Permit with plat valid without expiration. Improvement Permit with site plan valid for sixty months. Authorization to Construct is valid for a period equal to that of Improvement Permit – not to exceed sixty months.

Signed: date 12-2-02 Installed by: Corinthian Development

Improvement Permit by: RS date 11/27/02 Operation Permit by: Wendy Sparks RS date 3/6/03

Authorization to Construct by: RS date 12/2/02 Existing System Inspection by: date

HEALTH DEPT. COPY: WHITE OWNER COPY (FINAL): YELLOW OWNER COPY (INITIAL): PINK