IREDELL COUNTY HEALTH DEPARTMENT

STATESVILLE 704-878-5305 130.00 Paid MOORESVILLE 704-664-5281

IMPROVEMENT PERMIT / AUTHORIZATION TO CONSTRUCT / OPERATION PERMIT / EXISTING SYSTEM INSPECTION

PERMIT# 107032 PIN# ~~4639 76 5044.000~~ 4639-76-9275 DATE 6/10/02

OWNER OR CONTRACTOR CORINTHIAN DEVELOPMENT PHONE: Business 827-4697 Home

ADDRESS ~~159 CREEKWOOD DRIVE MOORESVILLE~~ PO BOX 990 DENVER NC 28037

LOCATION PERTH RD (N) - TL FERN HILL - TL CREEKWOOD DR. - 11th ON LT #159

SUBDIVISION CREEKWOOD VILLAGE BLOCK / SECTION LOT 11 LOT AREA .61AC SITE CLASS. PS DESIGN FLOW 360GPD L.T.A.R. .36/FT²

Septic Tank: 1000 Gallons; STB 785 Date 3-23-02

Pump Tank: Gallons; PT Date

Pump Make: Model Serial No.

Nitrification Field: No Fields 1 Square Feet ~~900~~ Linear Feet 300

No Lines 3@100' Trench Width 36" Max Trench Bottom Depth 36" Gravel Depth N/A

900/ft²

☑ New System ☐ Repair System Type: I, II, III, IV, V, VI

System Description: GRAVITY 25% REDUCTION

Repair System Description: LP PANEL

Maintenance Agreement Required: ☐ Yes ☑ No

☑ House/Mod. Home ☐ Mobile Home ☐ Business ☐ Other

No. Bedrooms 3 No. Bathrooms 3 No. Employees

☐ Slab ☑ Crawl Space ☐ Basement w/plumbing ☐ Basement wo/plumbing


Water Supply: ☑ Individual ☐ Public ☐ Community

Comments:/Conditions:


Comments:/Conditions: Checked Drainlines 7/11/2002 MD

~~Filter not installed yet~~, tank checked 8/22/02 MD

INITIAL SITE SKETCH 1" = 50'

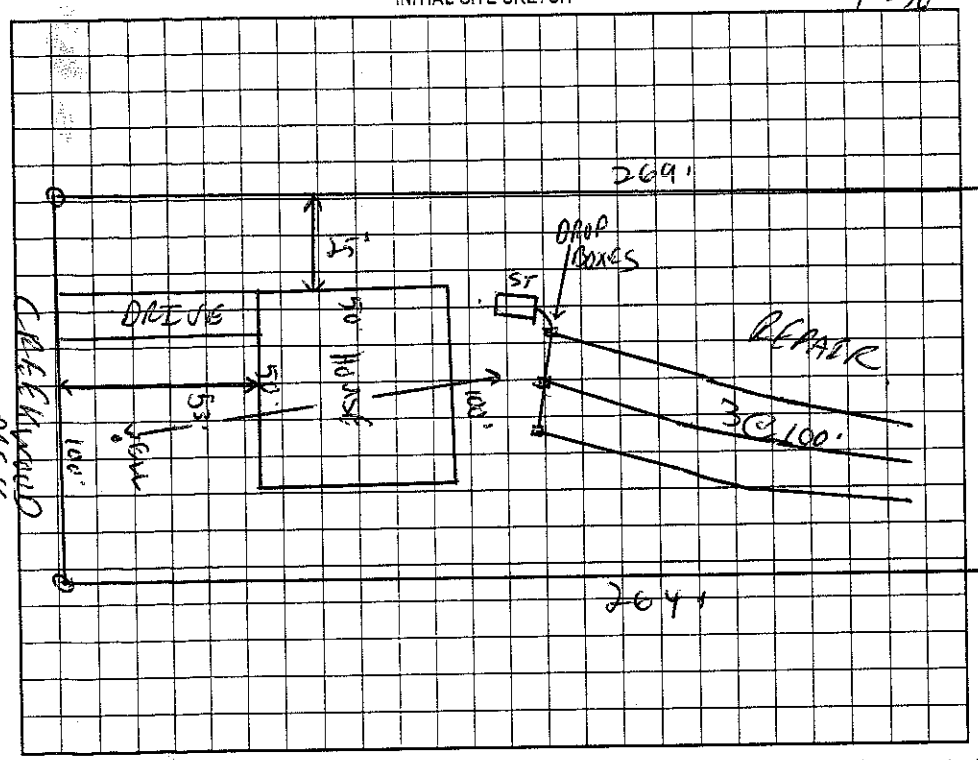

AS BUILT SKETCH

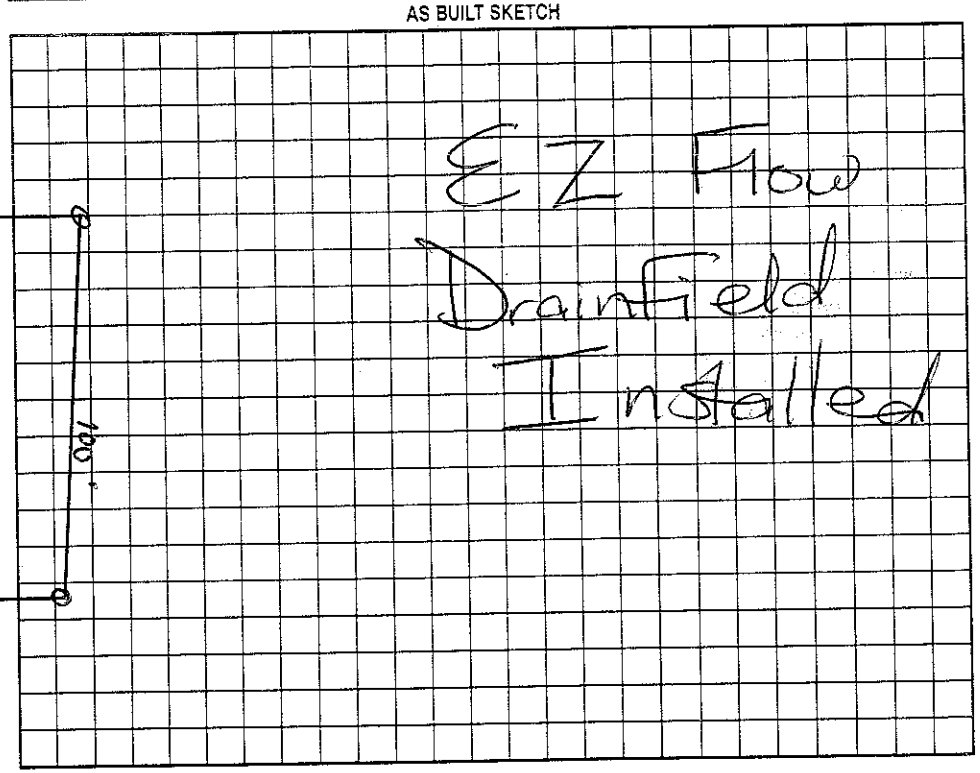

Permit can be suspended or revoked if any false information is supplied toward securing the permit/any unauthorized changes are made to the site/any unauthorized changes are made in the installation of the system. Improvement Permit with plat valid without expiration. Improvement Permit with site plan valid for sixty months. Authorization to Construct is valid for a period equal to that of Improvement Permit – not to exceed sixty months.

Signed: date 6-12-02 Installed by: Corinthian RS

Improvement Permit by: date 6/10/02 Operation Permit by: Maria H. Dobson date 8/22/2002

Authorization to Construct by: date 6/10/02 Existing System Inspection by: date

HEALTH DEPT. COPY: WHITE OWNER COPY (FINAL): YELLOW OWNER COPY (INITIAL): PINK