375 2100

IREDELL COUNTY HEALTH DEPARTMENT

STATESVILLE 704-878-5305 MOORESVILLE 704-664-5281

IMPROVEMENT PERMIT / AUTHORIZATION TO CONSTRUCT / OPERATION PERMIT / EXISTING SYSTEM INSPECTION

PERMIT# 106504 PIN# 4639768041.10 / 4639 76 9333 DATE 8/5/02

OWNER OR CONTRACTOR CORINTHIAN DEVELOPMENT PHONE: Business 887-9697 Home

ADDRESS PO Box 900 DENVER

LOCATION PERTH (N) - TL FERN HILL - TL CREEKWOOD - ON LT / 151 CREEKWOOD DR. .25

SUBDIVISION CREEKWOOD VILLAGE BLOCK / SECTION 1 LOT 10 LOT AREA .63AC SITE CLASS. AS DESIGN FLOW 600GPD L.T.A.R. .36 AC/LOT

Septic Tank: 1500 Gallons; STB 40 Date

Pump Tank: 1500 Gallons; PT 99 Date 7/3/01

Pump Make: MYERS Model ME-[redacted] Serial No.

Nitrification Field: No Fields 1 Square Feet 804 Linear Feet 402

No Lines 6@67' Trench Width 24" Max Trench Bottom Depth 36" Gravel Depth N/A

☑ New System ☐ Repair System Type: I, II, III, IV, V, VI

System Description: LPP PANEL

Repair System Description: SAME

Maintenance Agreement Required: ☑ Yes ☐ No

☐ House/Mod. Home No. Bedrooms 5

☐ Mobile Home No. Bathrooms 5

☐ Business No. Employees

☐ Other


☐ Slab ☑ Crawl Space ☐ Basement w/plumbing ☐ Basement wo/plumbing

Water Supply: ☑ Individual ☐ Public ☐ Community


Comments/Conditions: 1) DRIVE EITHER SIDE

Comments/Conditions:

INITIAL SITE SKETCH 1" = 50'

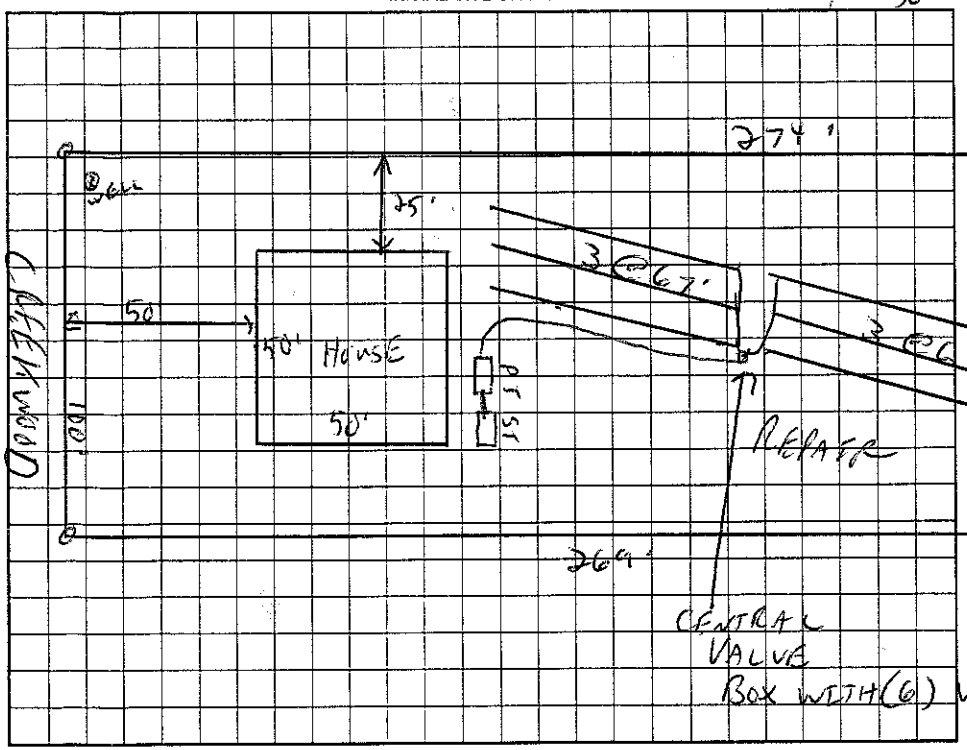

AS BUILT SKETCH

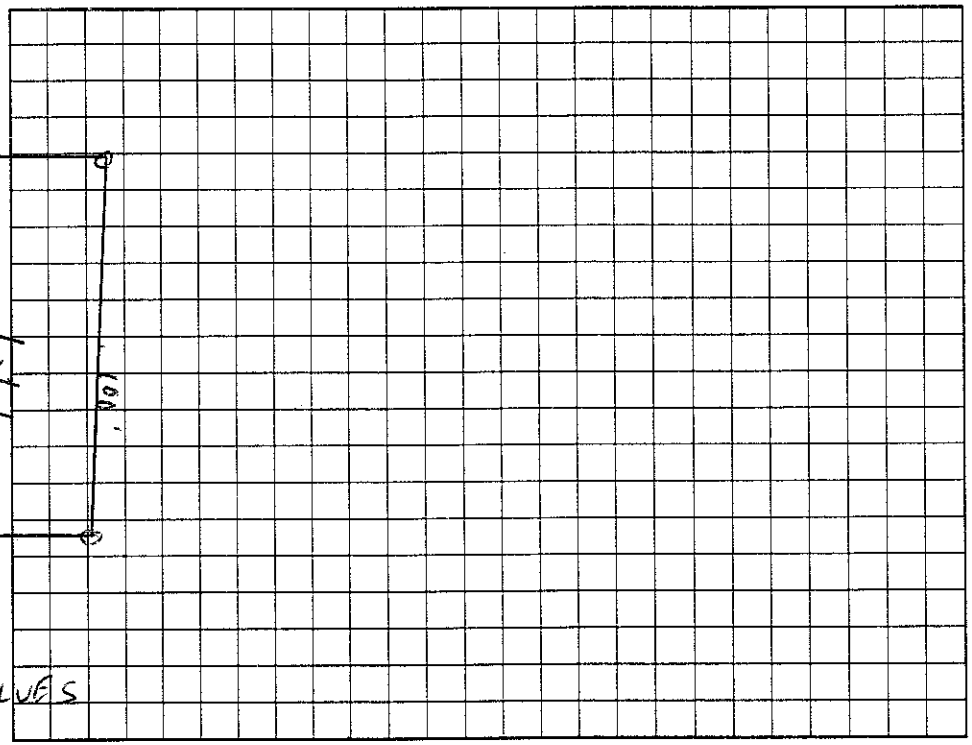

Permit can be suspended or revoked if any false information is supplied toward securing the permit/any unauthorized changes are made to the site/any unauthorized changes are made in the installation of the system. Improvement Permit with plat valid without expiration. Improvement Permit with site plan valid for sixty months. Authorization to Construct is valid for a period equal to that of Improvement Permit – not to exceed sixty months.

Signed: _____ date 8/6/12 Installed by: Corinthian Builders

Improvement Permit by: C. Hyatt RS date 8/5/02 Operation Permit by: _____ RS date 12/17/02

Authorization to Construct by: C. Hyatt RS date 8/5/02 Existing System Inspection by: _____ date _____

HEALTH DEPT. COPY: WHITE OWNER COPY (FINAL): YELLOW OWNER COPY (INITIAL): PINK