IREDELL COUNTY HEALTH DEPARTMENT

STATESVILLE 704-878-5305 130.00 Paid MOORESVILLE 704-664-5281

IMPROVEMENT PERMIT / AUTHORIZATION TO CONSTRUCT / OPERATION PERMIT / EXISTING SYSTEM INSPECTION

PERMIT# 106502 PIN# ~~4639 76 80 44.2X~~ 4639-77-3009 DATE 6/11/02

OWNER OR CONTRACTOR CORINTHIAN DEVELOPMENT PHONE: Business 872-9697 Home

ADDRESS PO BOX 990 DENVER NC 28037

LOCATION PERTH (N) - TL FERN HILL - TL CREEKWOOD - ON RT CORNER - 106 CREEKWOOD

SUBDIVISION CREEKWOOD VILLAGE BLOCK / SECTION LOT 24 LOT AREA .594AC SITE CLASS. PS DESIGN FLOW 360GPD L.T.A.R. 1.30-80/FT2

Septic Tank: 1000 Gallons; STB 786 Date 4/25/02
Pump Tank: Gallons; PT Date
Pump Make: Model Serial No.
Nitrification Field: No Fields 1 Square Feet 900 Linear Feet 300
No Lines ~~4 @ 75'~~ Trench Width 36" Max Trench Bottom Depth 36" Gravel Depth N/A

☑ New System ☐ Repair System Type: I, II, III, IV, V, VI
System Description: GRAVITY 25% REDUCTION
Repair System Description: LP PANEL
Maintenance Agreement Required: ☐ Yes ☑ No


☑ House/Mod. Home No. Bedrooms 3
☐ Mobile Home No. Bathrooms 3
☐ Business No. Employees
☐ Other
☐ Slab ☑ Crawl Space ☐ Basement w/plumbing ☐ Basement wo/plumbing

Water Supply: ☑ Individual ☐ Public ☐ Community

Comments:/Conditions: 36@80' 1@60'

Comments:/Conditions:

INITIAL SITE SKETCH 1" = 50'

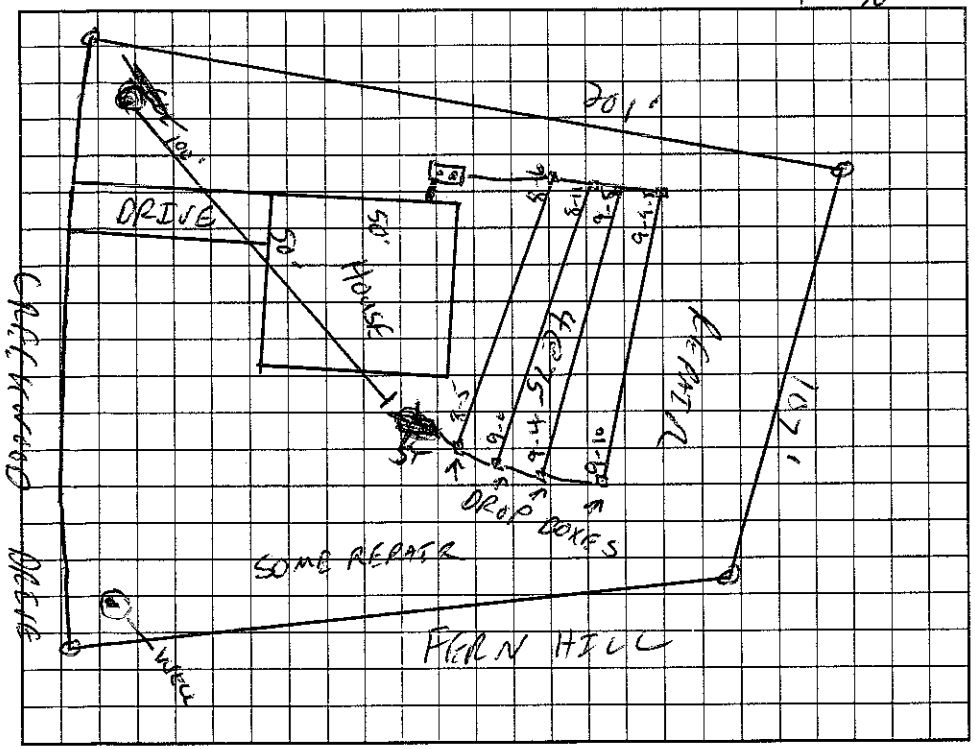

AS BUILT SKETCH

Permit can be suspended or revoked if any false information is supplied toward securing the permit/any unauthorized changes are made to the site/any unauthorized changes are made in the installation of the system. Improvement Permit with plat valid without expiration. Improvement Permit with site plan valid for sixty months. Authorization to Construct is valid for a period equal to that of Improvement Permit – not to exceed sixty months.

Signed: date 6-11-02 Installed by: Corinthian Development

Improvement Permit by: C. W. Zoutewelle RS date 6/11/02 Operation Permit by: Wesley Sparks RS date 2/13/03

Authorization to Construct by: Wesley Sparks RS date 1/13/03 Existing System Inspection by: date

HEALTH DEPT. COPY: WHITE OWNER COPY (FINAL): YELLOW OWNER COPY (INITIAL): PINK