IREDELL COUNTY HEALTH DEPARTMENT

STATESVILLE 704-878-5305 130.00 Paid MOORESVILLE 704-664-5281

IMPROVEMENT PERMIT / AUTHORIZATION TO CONSTRUCT / OPERATION PERMIT / EXISTING SYSTEM INSPECTION

PERMIT# 107014 PIN# 4639 76 8041.1 4639774293 DATE 4/30/03

OWNER OR CONTRACTOR CORINTHIAN DEVELOPMENT PHONE: Business 827-9697 Home

ADDRESS PO BOX 490 DENVER NC 28117

LOCATION PERTH RD - TL FERN HILL TOWARD LAKE - TL CREEKWOOD - ON LT CORNER.

SUBDIVISION CREEKWOOD BLOCK / SECTION 1 LOT 1 LOT AREA .63AC SITE CLASS. PS DESIGN FLOW 360GPD L.T.A.R. .3000 SQ FT

Septic Tank: 1000 Gallons; STB 7786 Date 4/12/03
Pump Tank: 1000 Gallons; PT 40 Date 1/6/03
Pump Make: MYERS Model MW-50-1HP Serial No. 7/16/03
Nitrification Field: No Fields 1 Square Feet 1200 Linear Feet 400
No Lines NEW/4 OLD Trench Width 36" Max Trench Bottom Depth 36" Gravel Depth 12"

☑ New System ☐ Repair System Type: I, II, (III), IV, V, VI
System Description: PUMP CONVENTIONAL
Repair System Description: PUMP 25% REDUCTION
Maintenance Agreement Required: ☐ Yes ☑ No


☑ House/Mod. Home No. Bedrooms 3
☐ Mobile Home No. Bathrooms 3
☐ Business No. Employees
☐ Other
☐ Slab ☑ Crawl Space ☐ Basement w/plumbing ☐ Basement wo/plumbing

Water Supply: ☑ Individual ☐ Public ☐ Community

Comments:/Conditions: 1) CUT OFF UPPER LINE AT 50' IN LENGTH. DIG OUT 10' AND TAMP CLEAN SOIL TO CREATE DAM. 2) CUT OFF 3RD EXISTING LINE AT OPPOSITE END AS UPPER LINE AND DO SAME AS UPPER LINE.

Comments:/Conditions: 3) CUT OFF 2nd LINE TO 90' IN LENGTH TO KEEP 10' FROM PROPERTY LINE AND DO SAME AS PREVIOUS LINES. 4) 4 TAPS TO BE INSTALLED WITH FLOW DIVIDER ON THE 2-50' LINES.

INITIAL SITE SKETCH

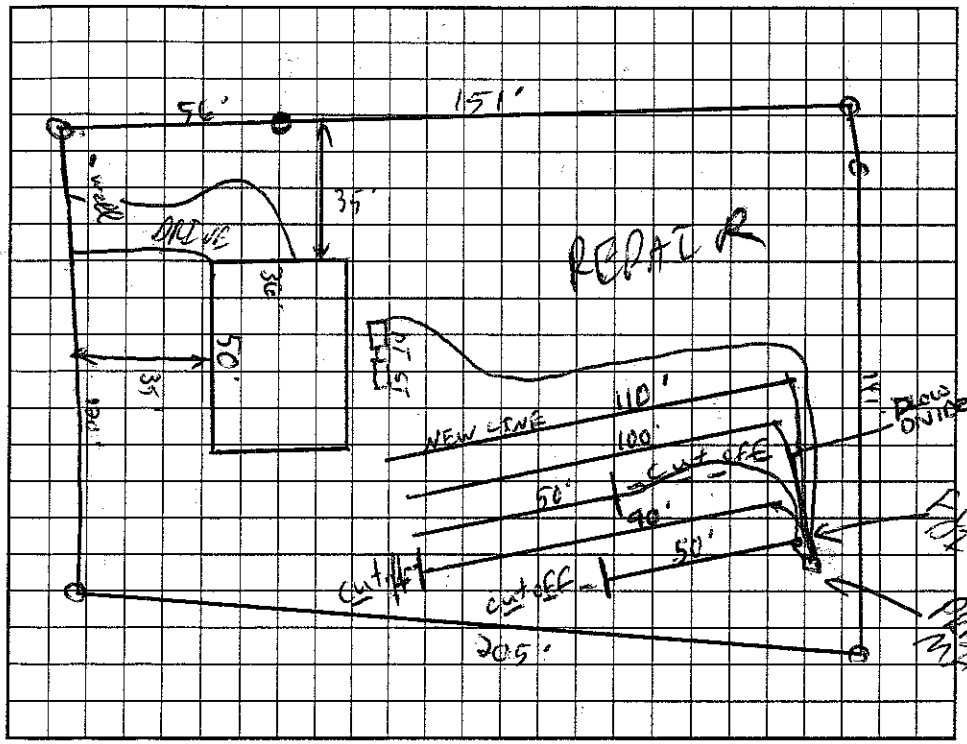

AS BUILT SKETCH

5) ~~X~~ FIND END OF EXISTING LINES TO DETERMINE ORIGINAL DISTRIBUTION

6) IF ORIGINAL DISTRIBUTION IS ON OPPOSITE ENDS OF PRESSURE MANIFOLD THE SECOND AND THIRD LINES ARE TO BE ABANDONED AND EXTRA 100' TO BE INSTALLED BELOW NEW 110' LINE.

7) ~~X~~ AFTER FINDING ORIGINAL DISTRIBUTION OF SYSTEM - CONSULT WITH HEALTH DEPARTMENT BEFORE INSTALLATION.

8/21/03 - EZ FLOW INSTALLED - FLOW DIVIDER INSTALLED.

Permit can be suspended or revoked if any false information is supplied toward securing the permit/any unauthorized changes are made to the site/any unauthorized changes are made in the installation of the system. Improvement Permit with plat valid without expiration. Improvement Permit with site plan valid for sixty months. Authorization to Construct is valid for a period equal to that of Improvement Permit – not to exceed sixty months.

Signed: _____ date 5-7-03 ; Installed by: Corinthian Builders

Improvement Permit by: _____ RS date 4/30/03 Operation Permit by: _____ RS date 9/8/03

Authorization to Construct by: _____ RS date 4/30/03 Existing System Inspection by: _____ date _____

HEALTH DEPT. COPY: WHITE OWNER COPY (FINAL): YELLOW OWNER COPY (INITIAL): PINK