IREDELL COUNTY HEALTH DEPARTMENT

STATESVILLE 704-878-5305 MOORESVILLE 704-664-5281

IMPROVEMENT PERMIT / AUTHORIZATION TO CONSTRUCT / OPERATION PERMIT / EXISTING SYSTEM INSPECTION

PERMIT# 121500 PIN# 4639801300 DATE 1-22-08

OWNER OR APPLICANT Rozalia Sirbu PHONE: Business 704-622-9434 Home 704-662-8089

ADDRESS 114 Sandreed Dr

LOCATION Perth Rd N TL Liva Ln TR Bay Crossing TR Summerwind next to last on right

SUBDIVISION Bay Crossing BLOCK / SECTION 1 LOT 120 LOT AREA 1.7 Ac SITE CLASS. PS DESIGN FLOW 600gpd L.T.A.R. .3gpd/ft²

Septic Tank: 1500 Gallons: STB 444 Date 1/8/08

Pump Tank: 1500 Gallons: PT 477 Date 1/11/08

Pump Make: Goulds Model WE5-3124 Serial No. 3107

Nitrification Field: No Fields 1 Square Feet 1500 Linear Feet 500

No Lines 6 Trench Width 36" Max Trench Bottom Depth 36" Gravel Depth NA ☐ Gravity ☒ Pressure

☒ New System ☐ Repair ☐ Expansion System Type: I II (III) IV V VI

System Description: 25% reduction pm

Repair System Description: 25% reduction pm

Maintenance Agreement Required: ☐ Yes ☒ No

☒ House/Mod. Home ☐ Mobile Home ☐ Business ☐ Other

No. Bedrooms 5 No. Persons 10 No. Employees

Water Supply: ☒ Individual ☐ Public ☐ Community


☐ Slab ☐ Crawl Space ☒ Basement w/plumbing ☐ Basement wo/plumbing

Comments:/Conditions: Keep system min. 15' sideslope from basement

Comments:/Conditions: 5@100'x3'

1" = 100'

INITIAL SITE SKETCH

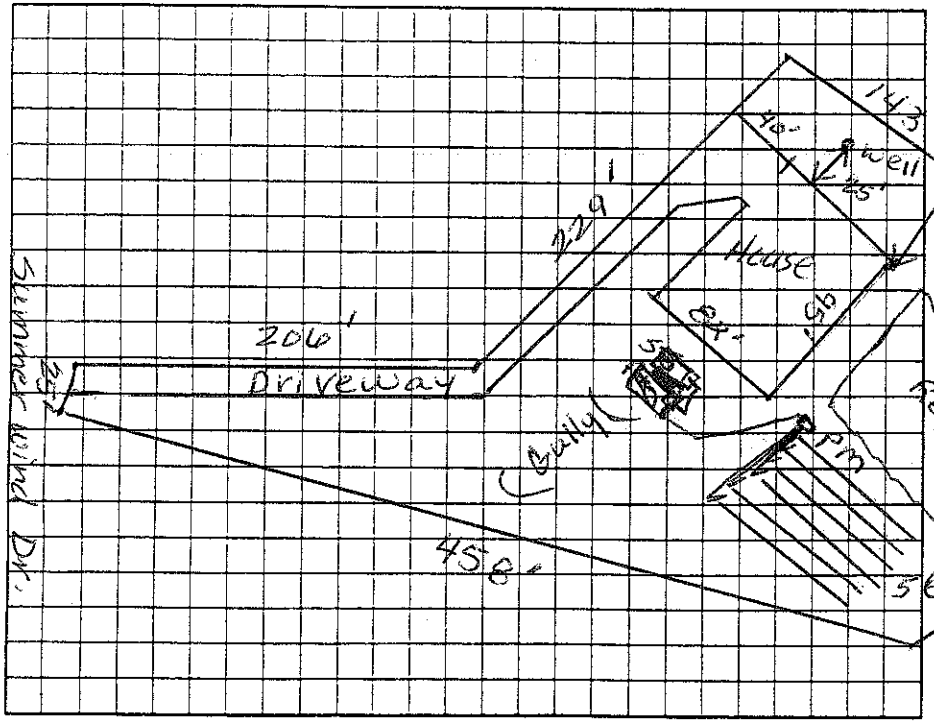

AS BUILT SKETCH

Permit can be suspended or revoked if any false information is supplied toward securing the permit/any unauthorized changes are made to the site/any unauthorized changes are made in the installation of the system. Improvement Permit with plat valid without expiration ☐ / Improvement Permit with site plan valid for sixty months ☒ Authorization to Construct is valid for a period equal to that of Improvement Permit – not to exceed sixty months.

Signed: Rozalia Sirbu date 1-29-08 Installed by: Technical Septic Tech

Improvement Permit by: Judy Melville date 1-22-08 Operation Permit by: Wesley Upchurch RS. date 4/1/08

Authorization to Construct by: Judy Melville date 1-22-08 Existing System Inspection by: date

HEALTH DEPT. COPY: WHITE OWNER COPY (FINAL): YELLOW OWNER COPY (INITIAL): PINK