IREDELL COUNTY HEALTH DEPARTMENT

STATESVILLE 704-878-5305 MOORESVILLE 704-664-5281

IMPROVEMENT PERMIT / AUTHORIZATION TO CONSTRUCT / OPERATION PERMIT / EXISTING SYSTEM INSPECTION

PERMIT# 12149 PIN# 4639619556.119 4639-80-1511 DATE 11/10/04

OWNER OR CONTRACTOR HECHT PROPERTIES PHONE: Business 483-3651 Home

ADDRESS 585 (N) HWY 16 DENVER, NC 28037

LOCATION PERTH (N) - TL LIVA LN - TR BAYCROSSING - TR SUMMER WIND. AT END

SUBDIVISION BAYCROSSING BLOCK / SECTION 1 LOT 119 LOT AREA 1.53Ac SITE CLASS. PS DESIGN FLOW 480GPD L.T.A.R. .36/.72

Septic Tank: ~~1500~~ Gallons: STB 444 Date 3/19/07

Pump Tank: Gallons; PT Date

Pump Make: Model Serial No.

Nitrification Field: No Fields 1 Square Feet 1200 Linear Feet 400

No Lines 4@100' Trench Width 36" Max Trench Bottom Depth 36" Gravel Depth

☑ New System ☐ Repair System Type: I, II, III, IV, V, VI

System Description: GRAVITY 25% REDUCTION

Repair System Description: SAME PUMPED

Maintenance Agreement Required: ☐ Yes ☑ No

☑ House/Mod. Home ☐ Mobile Home ☐ Business ☐ Other

No. Bedrooms 4 No. Bathrooms 4 No. Employees

Water Supply: ☑ Individual ☐ Public ☐ Community


☐ Slab ☑ Crawl Space ☐ Basement w/plumbing ☐ Basement wo/plumbing

Comments:/Conditions: 318'


Comments:/Conditions: STUB OUT PLUMBING HIGH TO ACHIEVE GRAVITY

1"=50'

INITIAL SITE SKETCH

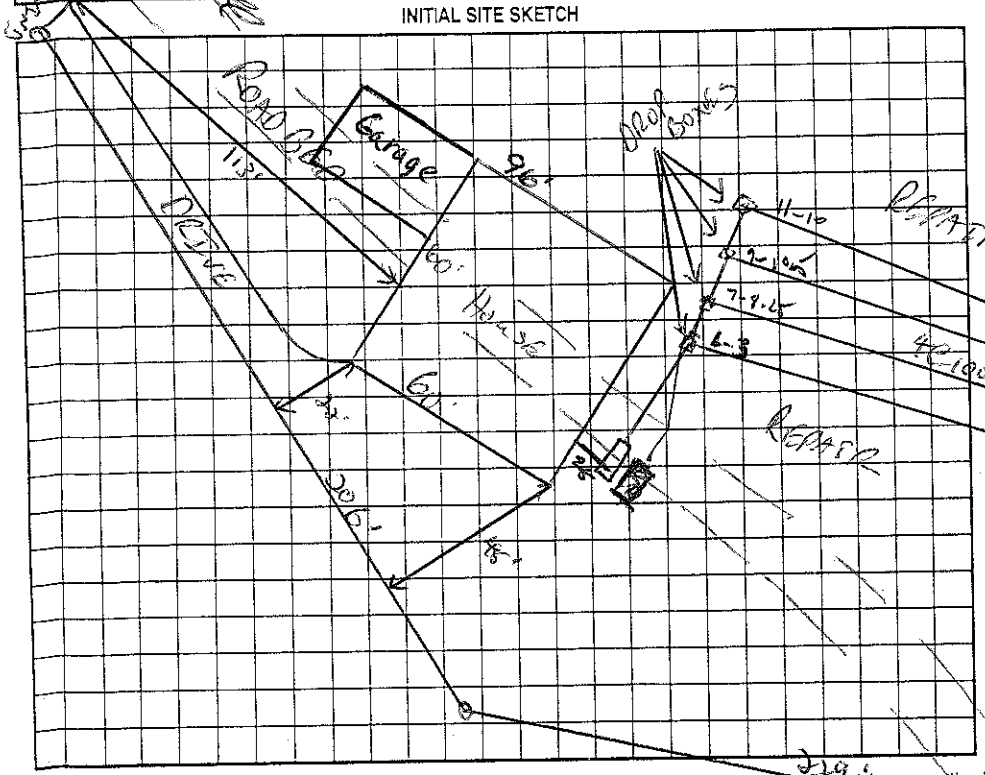

AS BUILT SKETCH

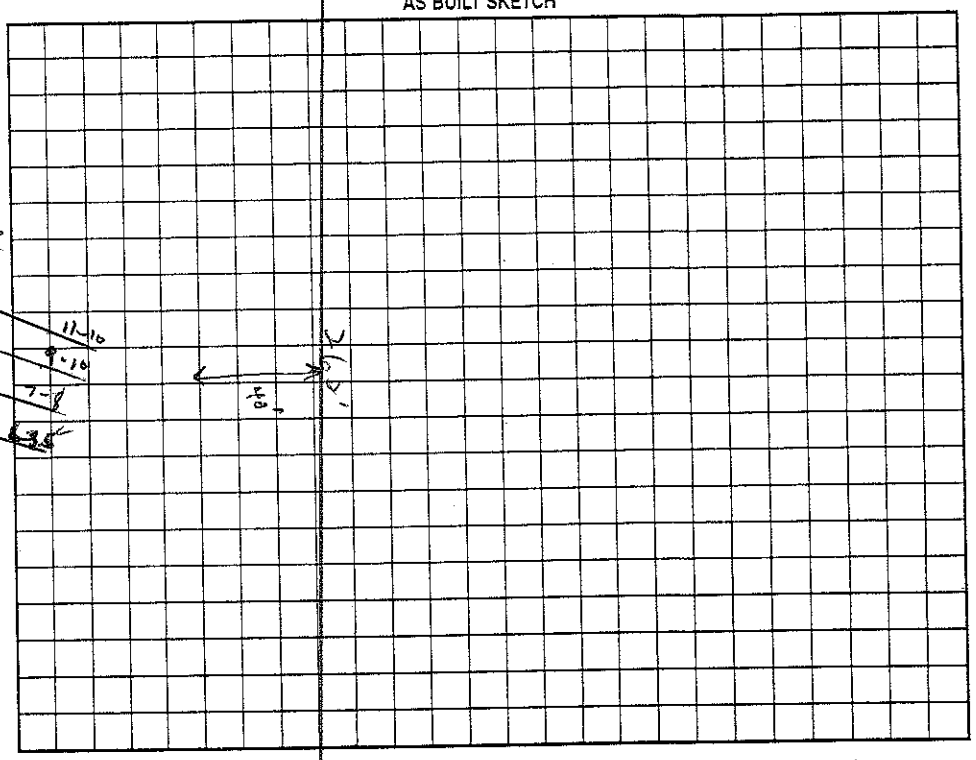

Permit can be suspended or revoked if any false information is supplied toward securing the permit/any unauthorized changes are made to the site/any unauthorized changes are made in the installation of the system. Improvement Permit with plat valid without expiration. Improvement Permit with site plan valid for sixty months. Authorization to Construct is valid for a period equal to that of Improvement Permit – not to exceed sixty months.

Signed: date 11-22-04 Installed by: Orbison

Improvement Permit by: RS date 11/10/04 Operation Permit by: Wesley Sparks RS date 3/18/07

Authorization to Construct by: Cindy Melville date 8-28-06 Existing System Inspection by: date

HEALTH DEPT. COPY: WHITE OWNER COPY (FINAL): YELLOW OWNER COPY (INITIAL): PINK