IREDELL COUNTY HEALTH DEPARTMENT

STATESVILLE 704-878-5305 MOORESVILLE 704-664-5281

IMPROVEMENT PERMIT / CERTIFICATE OF COMPLETION / OPERATION PERMIT / EXISTING SYSTEM INSPECTION

PROPERTY DESCRIPTION NO. 22209 DATE Dec 20, '95 TAX MAP NO. part of 25A51 4639 80 9063 Watershed: ☑ Yes ☐ No

OWNER OR CONTRACTOR Krom Financial Services PHONE: Business _____ Home _____ WS4CA

ADDRESS 149 Yacht Cove Rd., Mooresville

LOCATION Cornelius Rd. Turn on Creekview Rd. TR Millbros Ln. on left

SUBDIVISION Mills Pond BLOCK / SECTION 2 LOT 86 LOT AREA .55Ac SITE CLASS. PS DESIGN FLOW 360gpd L.T.A.R. .3

Septic Tank: 1000 Gallons; STB 825 Date 10/5/95

Pump Tank: 1000 Gallons; PT 49 Date 12/1/95

Pump Make: _____ Model _____ Serial No. _____

Nitrification Field: No Fields 1 Square Feet 1200 Linear Feet 400

No Lines 4@100' Trench Width 36" Max Trench Bottom Depth 36" Gravel Depth 12"

☑ New System ☐ Repair System Type: I, II, (III) IV, V, VI

System Description: pumped / pm / conventional

Repair System Description: " / " / INFILTRATOR

Maintenance Agreement Required: ☐ Yes ☑ No

☑ House/Mod. Home No. Bedrooms 3

☐ Mobile Home No. Bathrooms 2

☐ Business No. Employees _____

☐ Other _____

☐ Slab ☑ Crawl Space ☐ Basement w/plumbing ☐ Basement wo/plumbing


Water Supply: ☑ Individual ☐ Community ☐ Public

Comments:

Comments:

@ 1" = 50'

INITIAL SITE SKETCH

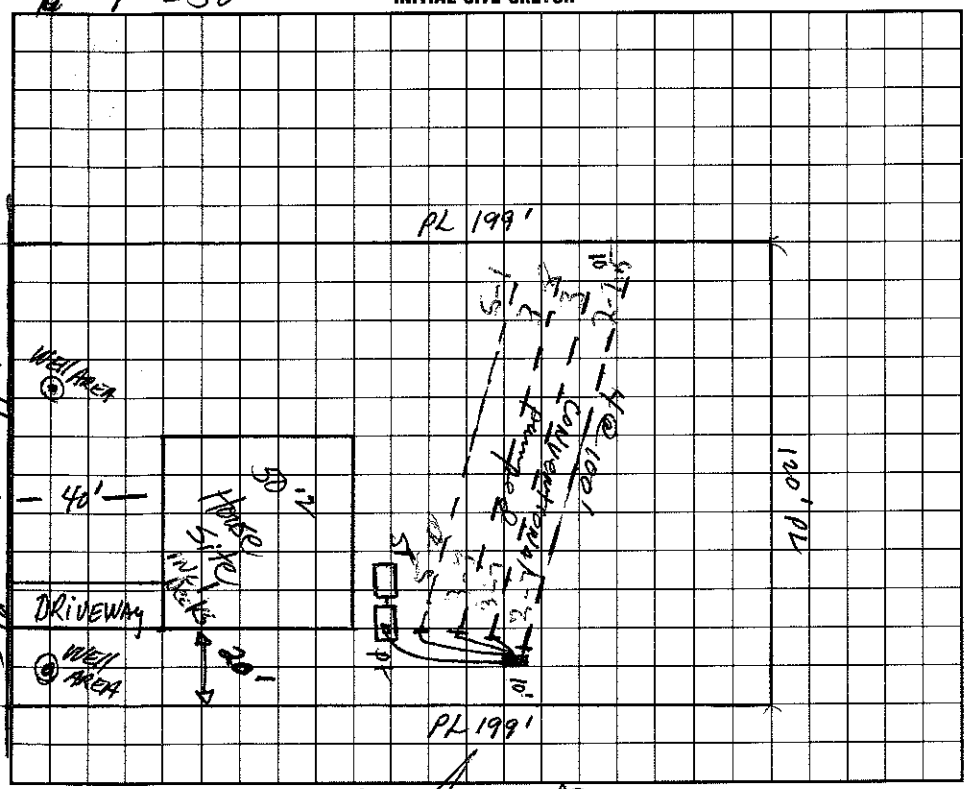

AS BUILT SKETCH

I understand that this permit can be suspended or revoked if any false information is supplied toward securing the permit/any unauthorized changes are made to the site/any unauthorized changes are made in the installation of the system.

Signed: X _____

Improvement Permit by: _____ date 12-20-95

Existing System Inspection by: Authorization to construct _____ date 12-21-95

Installed by: Rowan Septic Tank

Certificate of Completion by: Wesley Sparks R.S. date 2/28/96

Operation Permit by: Wesley Sparks R.S. date 2/29/96

HEALTH DEPT. COPY: WHITE INSPECTION COPY (FINAL): GREEN OWNER COPY (FINAL): YELLOW INSPECTION COPY (INITIAL): PINK OWNER COPY (INITIAL): GOLD