IREDELL COUNTY HEALTH DEPARTMENT

Statesville Office (704) 878-5305 Mooresville Office (704) 660-3625 PERMIT # 152015

IMPROVEMENT PERMIT / AUTHORIZATION TO CONSTRUCT / OPERATION PERMIT / EXISTING SYSTEM

PIN # 4639-84-0054

APPLICANT: MERITAGE HOMES APPLICANT ADDRESS: 7761 BALLANTYNE COMMONS PKWY

SITE ADDRESS: 168 RELFRY LOOP PHONE: 704-944-8900 ALT. PHONE:

SITE DIRECTIONS: PERTH, BELLS CROSSING, RELFRY, ON R

SUBDIVISION: BELLS CROSSING SECTION: LOT # 202 LOT AREA: .65 AC DESIGN FLOW: 480 L.T.A.R.: .25

Septic Tank	1000 (gal)	STB	760	Date	11-7-12	☒ New System	☐ Repair	☐ Expansion	System Type: I II (III) IV V VI	☒ Residence	No. Bedrooms 4
Pump Tank	1000 (gal)	PT	363	Date	2-25-13	System Description:	PM-25% REDUCTION			☐ Business	No. Persons
Pump Make	ZOELLER	Model	N153	Serial #		Repair System Description:	LP- PANEL BLOCK			☐ Other	No. Employees
# Nitrification Fields	1	# Lines	9	Linear Ft:	485'	Maintenance Agreement Required:	☐ YES	☒ NO		☒ Slab	☐ Crawl Space
Trench Width	36"	Max. Trench Bottom Depth	36"	Gravel Depth	—		☐ GRAVITY	☒ PRESSURE		☐ Basement w/plumbing	

Water Supply: ☐ Private ☐ Public ☒ Community ☐ Basement w/o plumbing

Comments / Conditions: 4/24/13 Uncovered Tanks, Uncovered Upper 3 Lines 4/26/13 MJS


Uncovered Quick 9

INITIAL SITE SKETCH

PM TAP SIZES


1 = 3/4" SCH 40
2 = 3/4" SCH 80
3 = 1/2" SCH 40
4 & 5 } 1/2" SCH 80
6 & 7 }
8 & 9 }

PLUMB TOGETHER LINES
4 & 5
6 & 7
8 & 9

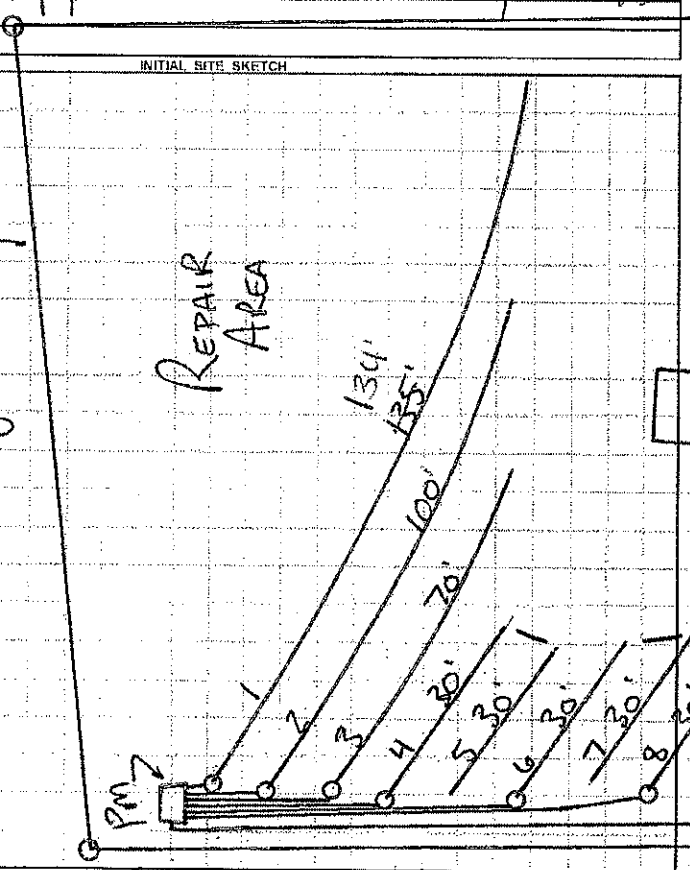

AS BUILT SKETCH

1" = 30'

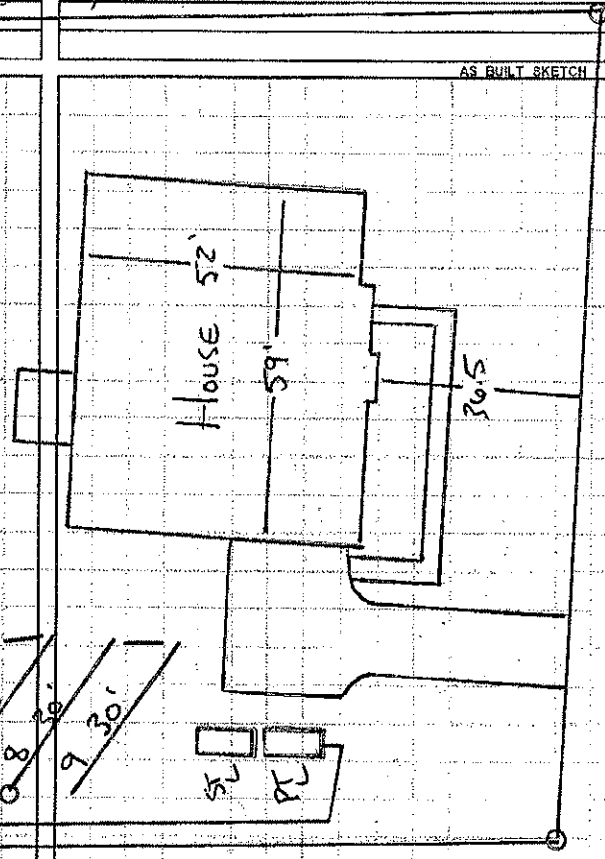

Permit can be suspended or revoked if any false information is supplied toward securing the permit / any unauthorized changes are made to the site / any unauthorized changes are made in the installation of the system. **CONTACT A LOCATOR SERVICE PRIOR TO ANY EXCAVATION**

☐ **IMPROVEMENT PERMIT** *with plat valid without expiration.* ☒ **IMPROVEMENT PERMIT** *with site plan valid for 60 mos.* ☒ **AUTHORIZATION TO CONSTRUCT** *valid for period equal to IMPROVEMENT PERMIT--not to exceed 60 mo.*

Owner / Applicant Signature: Date: 2-21-13 Installed by: Carolina Pipe Cleaning

IMPROVEMENT PERMIT by: Date: 2-20-13 OPERATION PERMIT by: Date: 10-11-13

AUTHORIZATION TO CONSTRUCT by: Date: 2-20-13 Existing System Inspected by: Date:

Health Dept. Copy - WHITE Applicant (Final Approval) - YELLOW Applicant (Conditional Approval) - PINK