IREDELL COUNTY HEALTH DEPARTMENT

STATESVILLE 704-878-5305 MOORESVILLE 704-664-5281

IMPROVEMENT PERMIT / AUTHORIZATION TO CONSTRUCT / OPERATION PERMIT / EXISTING SYSTEM INSPECTION

PERMIT# 152482 PIN# ~~4639-83-4045.000~~ 4639840770 DATE 9-8-08

OWNER OR APPLICANT Bells Crossing LLC PHONE: Business 704-663-1600 Home

ADDRESS 127 B Promenade Dr Mooresville NC 28117

LOCATION Perth TL Bells Crossing on R

SUBDIVISION Bells Crossing BLOCK / SECTION LOT 71 LOT AREA .89 Ac SITE CLASS. PS DESIGN FLOW 480 L.T.A.R. .3

Septic Tank: 1000 Gallons: STB 760 Date 2-21

Pump Tank: Gallons: PT Date

Pump Make: Model Serial No.

Nitrification Field: No Fields 1 Square Feet 1206' Linear Feet 402'

No Lines 3@134' Trench Width 36" Max Trench Bottom Depth 36" Gravel Depth —

☒ New System ☐ Repair ☐ Expansion System Type: I II III IV V VI

System Description: Gravity 25% Red.

Repair System Description: LP-Panel Block

Maintenance Agreement Required: ☐ Yes ☒ No Initially

☒ Gravity ☐ Pressure

☒ House/Mod. Home ☐ Mobile Home ☐ Business ☐ Other

No. Bedrooms 4 No. Persons 8 No. Employees


☐ Slab ☒ Crawl Space ☐ Basement w/plumbing ☐ Basement wo/plumbing

Water Supply: ☐ Individual ☐ Public ☒ Community


Comments:/Conditions: 1) Install per plan specs attached by Rollans Soil + Env. Services 2) Maintain setbacks

Comments:/Conditions:

INITIAL SITE SKETCH

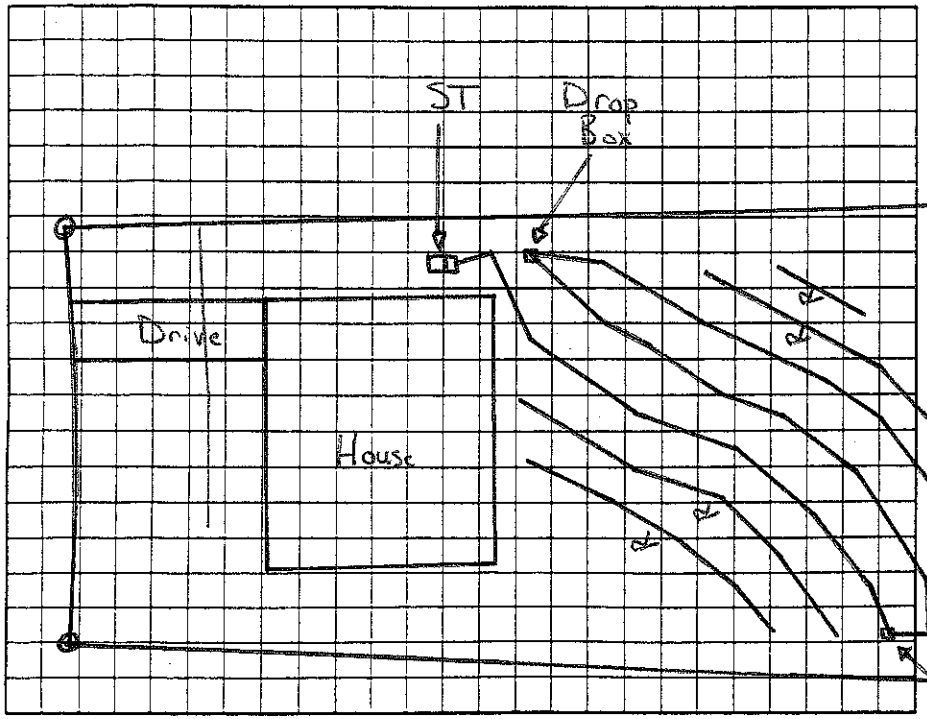

AS BUILT SKETCH

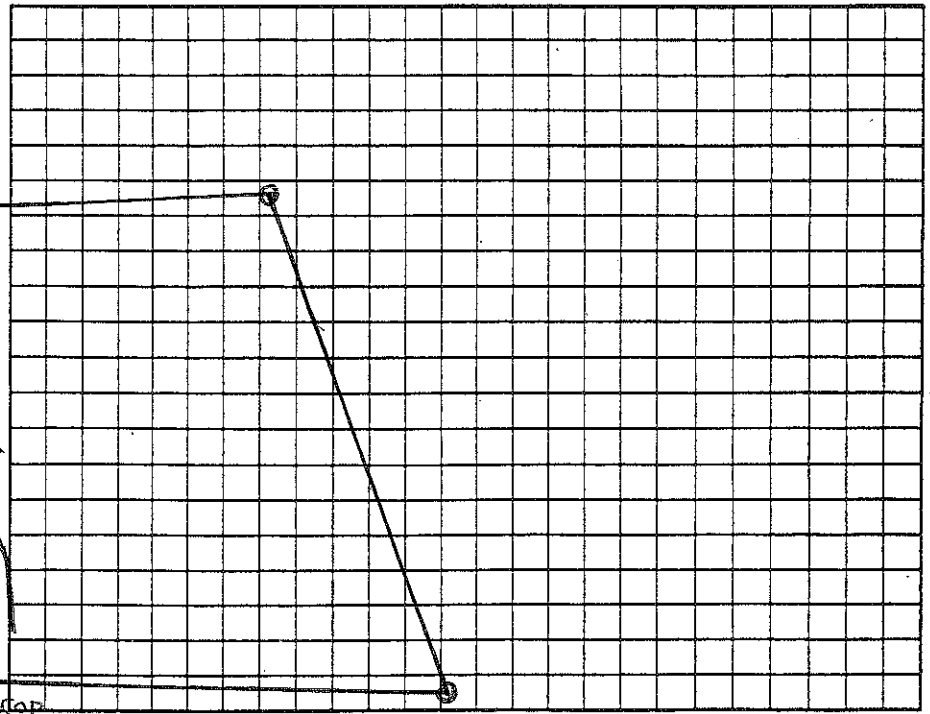

Permit can be suspended or revoked if any false information is supplied toward securing the permit/any unauthorized changes are made to the site/any unauthorized changes are made in the installation of the system. Improvement Permit with plat valid without expiration ☒ Improvement Permit with site plan valid for sixty months ☐ Authorization to Construct is valid for a period equal to that of Improvement Permit – not to exceed sixty months.

Signed: date 9/12/08 Installed by: CPA

Improvement Permit by: date 9-8-08 Operation Permit by: date 5-29-13

Authorization to Construct by: date 4/21/13 Existing System Inspection by: date

HEALTH DEPT. COPY: WHITE OWNER COPY (FINAL): YELLOW OWNER COPY (INITIAL): PINK