IREDELL COUNTY HEALTH DEPARTMENT

Statesville Office (704) 878-5305 Mooresville Office (704) 660-3625 PERMIT # 152016

IMPROVEMENT PERMIT / AUTHORIZATION TO CONSTRUCT / OPERATION PERMIT / EXISTING SYSTEM

PIN # 4639-84-1079

APPLICANT: MERITAGE HOMES APPLICANT ADDRESS: 7761 BALLANTYNE COMM. PKWY

SITE ADDRESS: 166 BELFRY LOOP PHONE: 704-944-8900 ALT. PHONE:

SITE DIRECTIONS: PERTH, BELLS CROSSING, BELFRY, ON R

SUBDIVISION: BELLS CROSSING SECTION: LOT # 203 LOT AREA: .71 AC DESIGN FLOW: 480 L.T.A.R.: .25

Septic Tank 1000 (gal) STB 760 Date 4-11-12
Pump Tank 1000 (gal) PT 3163 Date
Pump Make Zoeller Model BN151 Serial #
Nitrification Fields 1 # Lines 4@120' Linear Ft 480
Trench Width 36" Max. Trench Bottom Depth 36" Gravel Depth —


☒ New System ☐ Repair ☐ Expansion System Type: I II III IV V VI
System Description: PM - 25% REDUCTION
Repair System Description: LP - PANEL BLOCK
Maintenance Agreement Required: ☐ YES ☒ NO
☐ GRAVITY ☒ PRESSURE

☒ Residence No. Bedrooms 4
☐ Business No. Persons
☐ Other No. Employees
☒ Slab ☐ Crawl Space
☐ Basement w/plumbing ☐ Basement w/o plumbing


Water Supply: ☐ Private ☐ Public ☒ Community

Comments / Conditions: * No note on PT, let set 28days 234. 3/28/13 Checked tanks & lines, used Quick 4 ~~Installed~~ as Drawn

INITIAL SITE SKETCH

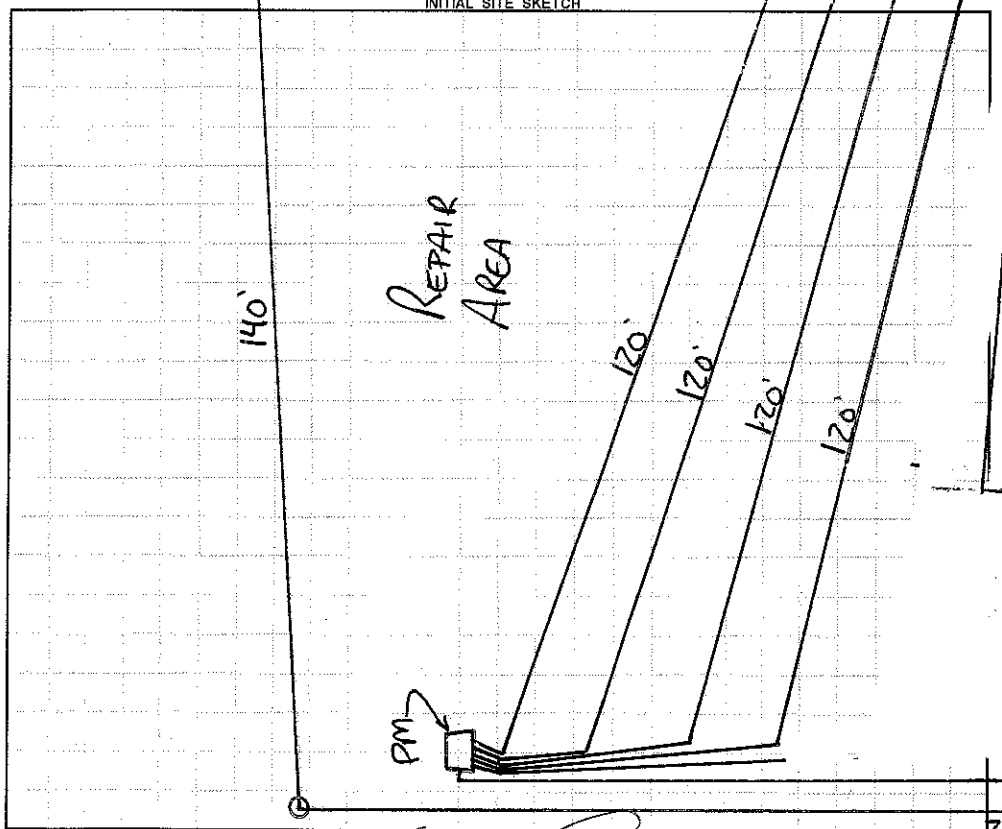

AS BUILT SKETCH

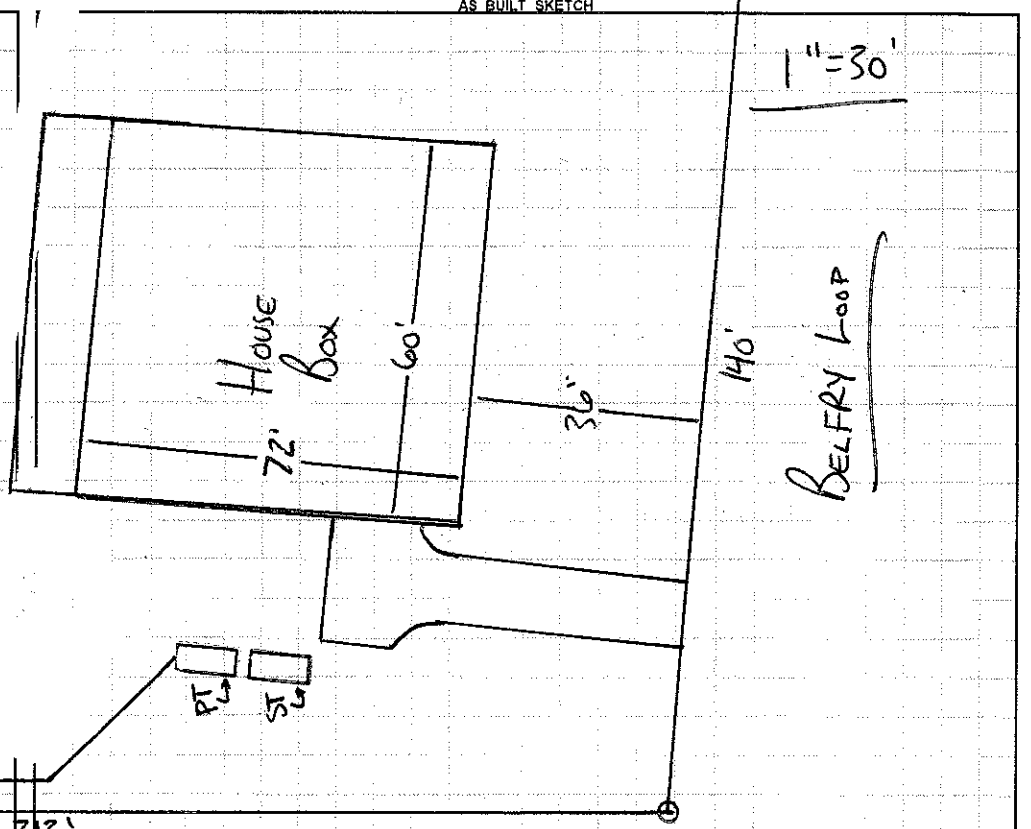

Permit can be suspended or revoked if any false information is supplied toward securing the permit / any unauthorized changes are made to the site / any unauthorized changes are made in the installation of the system. **CONTACT A LOCATOR SERVICE PRIOR TO ANY EXCAVATION**

☐ **IMPROVEMENT PERMIT** *with plat valid without expiration.* ☐ **IMPROVEMENT PERMIT** *with site plan valid for 60 mos.* ☒ **AUTHORIZATION TO CONSTRUCT** *valid for period equal to IMPROVEMENT PERMIT--not to exceed 60 mo.*

Owner / Applicant Signature: Date: 2-20-13 Installed by: Carolina Pipe

IMPROVEMENT PERMIT by: Date: 2-20-13 OPERATION PERMIT by: Date: 6-11-13

AUTHORIZATION TO CONSTRUCT by: Date: 2-20-13 Existing System Inspected by: Date:

Health Dept. Copy - WHITE Applicant (Final Approval) - YELLOW Applicant (Conditional Approval) - PINK