IREDELL COUNTY HEALTH DEPARTMENT

STATESVILLE 704-878-5305 ✓MOORESVILLE 704-664-5281

IMPROVEMENT PERMIT / AUTHORIZATION TO CONSTRUCT / OPERATION PERMIT / EXISTING SYSTEM INSPECTION

PERMIT # 150965 PIN # 4639-84-2195 DATE 11-29-12

OWNER or APPLICANT MERITAGE Homes PHONE: Business 704-351-5405 ~~Home~~ GERALD BOSWELL

OWNER or APPLICANT ADDRESS 7761 BALLANTYNE COMMONS PKWY

LOCATION / DIRECTIONS PERTH, TL BELLS CROSSING, TL BEIFRY LP, ON R

SUBDIVISION BELLS CROSSING BLOCK / SECTION LOT # 204 LOT AREA .66 AC DESIGN FLOW 600 L.T.A.R. .25

Septic Tank 1500 Gallons: STB 964 Date 1-6-13

Pump Tank 1500 Gallons: PT 5163 Date 8-28-12

Pump Make ZOELLER Model N-152 Serial #

Nitrification Field No Fields 1 No Lines 6 Linear Feet 600'

Trench Width 36" Max. Trench Bottom Depth 32" Gravel Depth —

☒ New System ☐ Repair ☐ Expansion System Type I II (III) IV V VI

System Description: PM- 25% REDUCTION

Repair System Description: PANEL

Maintenance Agreement Required ☐ YES ☒ NO

☐ GRAVITY ☒ PRESSURE

☒ Residence No. Bedrooms 5

☐ Business No. Persons

☐ Other No. Employees

☒ Slab ☐ Crawl Space


☐ Basement w/plumbing ☐ Basement w/o plumbing

Water Supply: ☐ Private ☐ Public ☒ Community

Comments / Conditions

Comments / Conditions

INITIAL SITE SKETCH

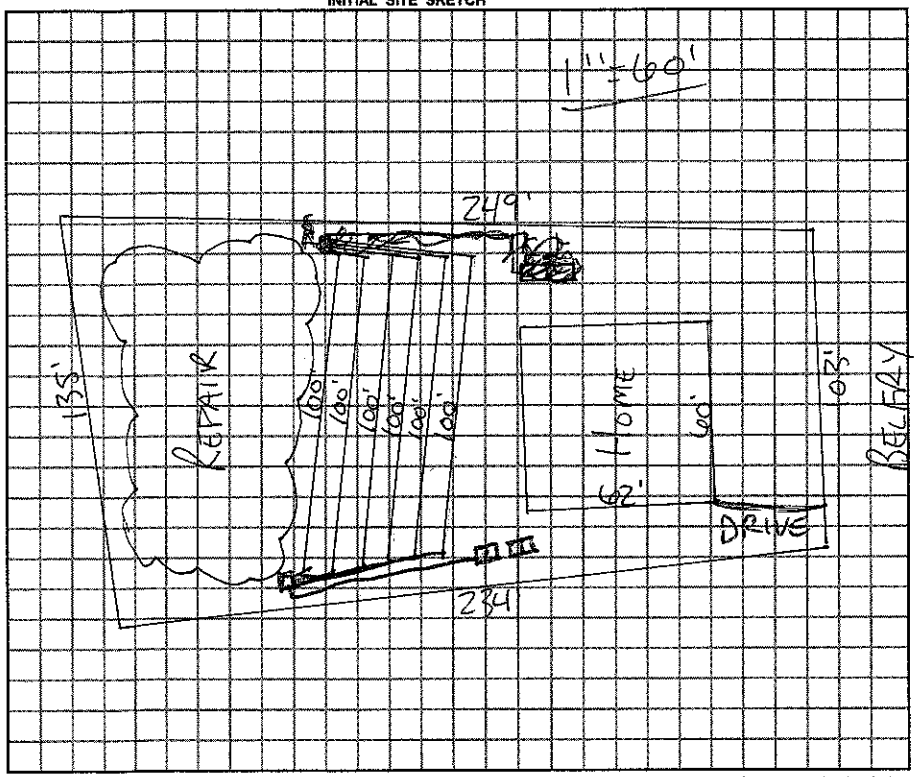

AS BUILT SKETCH

OK TO FLIP HOUSE. SEE REVISED PLAN TANKS TO GO ON OTHER SIDE OF HOUSE. 3-12-13 RA

CHECKED LINES & TANKS 3-18-13

SET 2 PM CHECKED BREAKERS 2 FLOATS PIGGYBACK 3-19-13 CHECKED PM 3-19-13

Permit can be suspended or revoked if any false information is supplied toward securing the permit / any unauthorized changes are made to the site / any unauthorized changes are made in the installation of the system.

☐ *IMPROVEMENT PERMIT w / plat valid without expiration.* ☒ *IMPROVEMENT PERMIT w / site plan valid for 60 mos.* ☒ *AUTHORIZATION TO CONSTRUCT valid for period equal to IMPROVEMENT PERMIT-not to exceed 60 mo.*

Owner / Applicant Signature: G Boswell Date 12-6-12

Improvement Permit by: RA Date 11-29-12

Authorization to Construct by: RA Date 11-29-12

YOU SHOULD CONTACT A LOCATOR SERVICE PRIOR TO ANY EXCAVATION.

Installed by: CAROLINA PIPE CLEANING

Operation Permit by: RA Date: 3-19-13

Existing System Inspected by: Date:

WHITE COPY Environmental Health YELLOW COPY (Final) Owner / Applicant PINK COPY (Initial) Owner / Applicant