
Bells Crossing
Lot 204

Approved as Noted
Plans submitted ONLY!
Date 11-14-12
Date 12-5-12

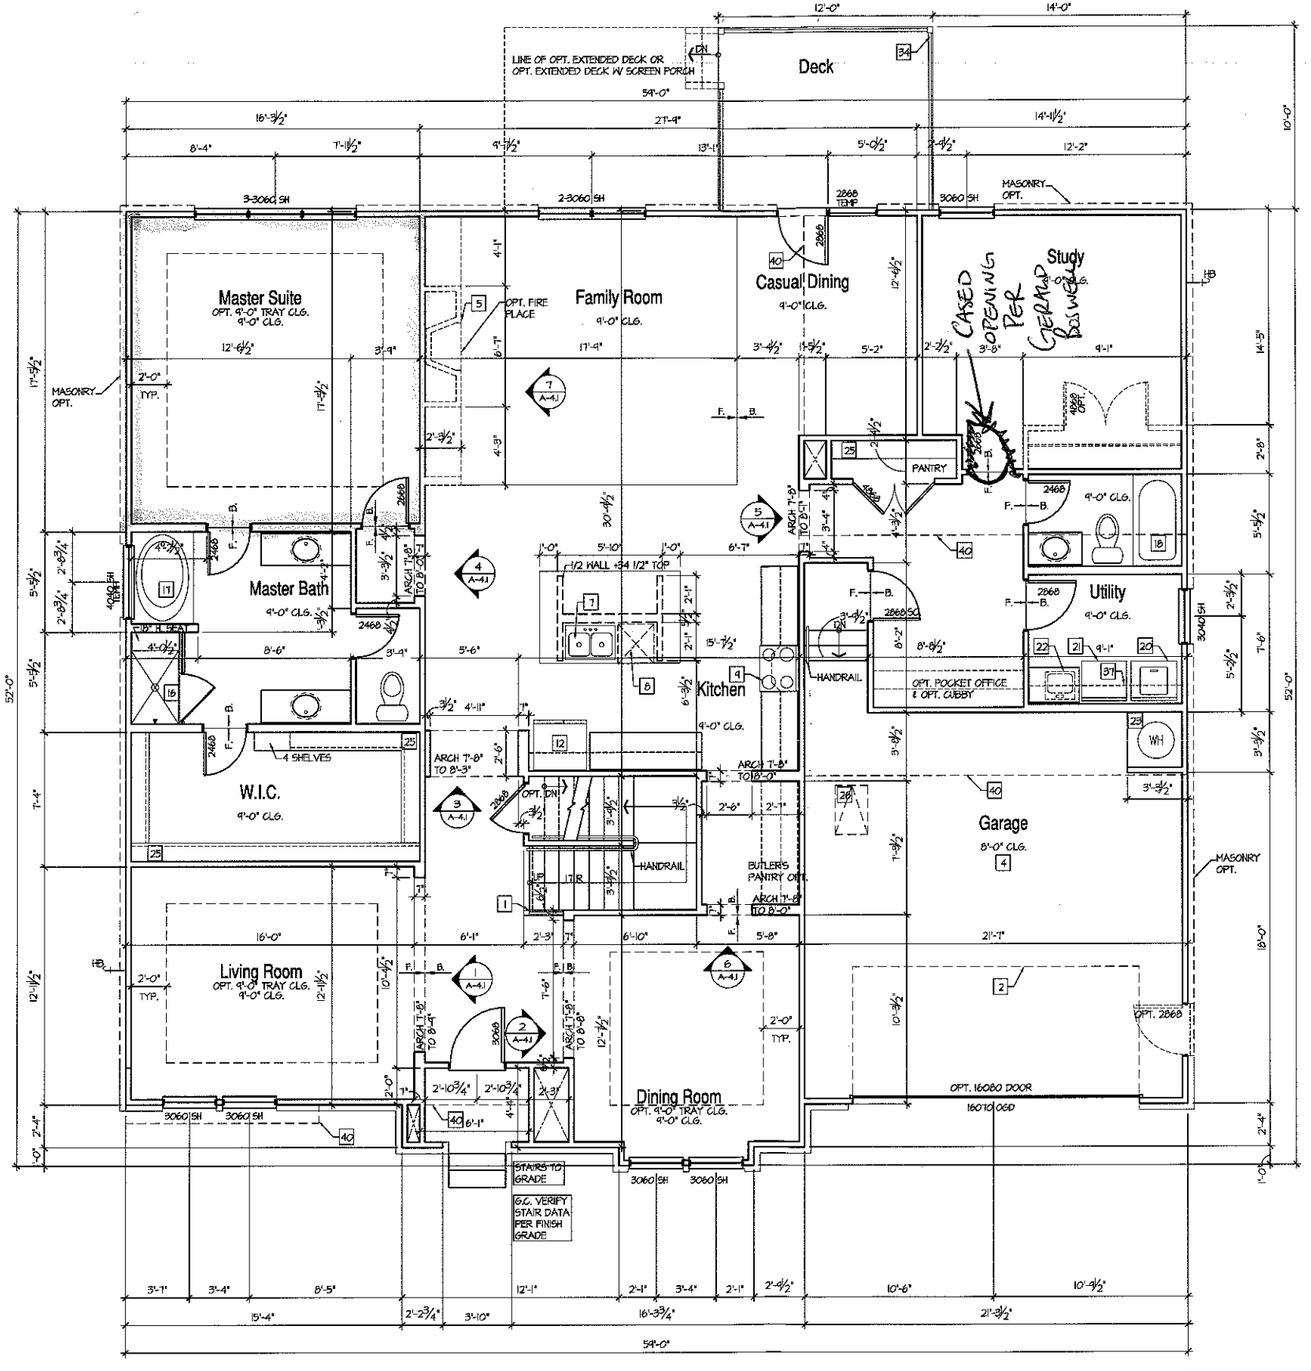


## Main Floor Plan "C"

SCALE: 1/4"=1'-0"

## TYPICAL CONSTRUCTION ASSEMBLIES:

A. TYPICAL ROOF CONSTRUCTION:
ASPHALT ROOF SHINGLES

B. TYPICAL FRAME FLOOR CONSTRUCTION:
FINISH FLOORING ON 3/4" TONGUE & GROOVE FLOOR SHEATHING ON FLOOR TRUSSES OR FLOOR JOISTS AS NOTED ON STRUCTURAL DRAWINGS.

C. SLAB ON GRADE FLOOR CONSTRUCTION:
4" CONCRETE SLAB, EXCEPT AS SPECIFIED BY SOIL REPORT, AND STRUCTURAL ENGINEER. INCLUDE VAPOR BARRIER PER SECTION IV, C, 3, a.

D. WINDOWS:
A. ALL WINDOWS SHALL COMPLY WITH MINIMUM STANDARDS OUTLINED IN APPLICABLE RES. CHECKS.
B. WINDOW SUPPLIER TO VERIFY AT LEAST ONE WINDOW IN ALL BEDROOMS TO HAVE A CLEAR EGRESS OPENING OF 5.7 SQ. FT. WITH MIN. DIMENSION OF 24" IN HEIGHT AND 20" IN WIDTH; SILL HEIGHT NOT GREATER THAN 44" ABOVE FLOOR.
C. TYPICAL WINDOW HEAD HEIGHT:
7'-0" A.F.F. @ 8'-1 1/8" PLATE HEIGHT (U.N.O.)
8'-0" A.F.F. @ 9'-1 1/8" PLATE HEIGHT (U.N.O.)

E. ELECTRICAL:
ALL ELECTRICAL AND MECHANICAL EQUIPMENT & METERS ARE SUBJECT TO RELOCATION DUE TO FIELD CONDITIONS; CONTRACTOR TO VERIFY.

F. HVAC:
PROVIDE BACK DRAFT DAMPERS @ DRYER VENT, HOOD VENT, & EXHAUST FANS.

G. STONE SIDING:
INSTALL PER LOCAL CODE.

H. DIMENSIONS ARE TO THE FACE OF STUD, U.N.O.

I. ALL EXTERIOR DIMENSIONS ARE TO FACE OF STUDS UNLESS OTHERWISE NOTED.

M. ALL ANGLED PARTITIONS ARE 45 DEGREES UNLESS OTHERWISE NOTED.

N. BRICK SIDING:
INSTALL PER LOCAL CODE.

## FLOOR PLAN NOTES:

[NOTE_FLOOR]

9 THE FOLLOWING KEYNOTES REFERENCE THE SYMBOLS AS SHOWN ON PLANS:

1. IF RAILING / GUARDRAIL IS PROVIDED, ALL RAILING / GUARDRAIL BALUSTERS TO BE SPACED SUCH THAT A 4" SPHERE CANNOT PASS BETWEEN BALUSTERS. RAILING/HANDRAILS ARE TO BE AT A 34" MINIMUM TO 38" MAXIMUM HEIGHT A.F.F., WITH RETURNS PER LOCAL CODE. RAILING AT GUARDRAIL LOCATIONS TO BE AT 42" MINIMUM A.F.F. OPT. RAILING.
2. LINE OF OVERHEAD GARAGE DOOR IN OPEN POSITION.
3. NOT USED
4. SLOPE GARAGE FLOOR 1/8" PER FOOT TOWARD OVERHEAD GARAGE DOOR OPENING.
5. FIREPLACE, AS SPECIFIED BY BUILDER. INSTALL PER MANUFACTURERS SPECIFICATIONS. ALL FACTORY BUILT FIREPLACES SHALL COMPLY WITH LOCAL CODES
6. NOT USED
7. SINK W/ GARBAGE DISPOSAL
8. DISHWASHER
9. RANGE
10. COOK TOP
11. OVEN
12. REFRIGERATOR SPACE.
13. PANTRY
14. PEDESTAL SINK
15. NOT USED
16. 36"x48" SHOWER
17. 42"x60" TUB
18. 32" X 60" TUB
19. LINEN
20. WASHER SPACE
21. DRYER, VENT
22. OPTIONAL LAUNDRY SINK.
23. PROVIDE NON-COMBUSTIBLE PLATFORM ELEVATED 18" ABOVE GARAGE FLOOR FOR WATER HEATER.
24. NOT USED
25. SHELVING PER BUILDER SPECS.
26. ATTIC ACCESS (22"x32" U.N.O.).
27. ATTIC ACCESS W/ STAIRS (22 1/2"x54" U.N.O.).
28. GYPSUM BOARD OPENING @ 8'-0" AT MAIN FLOOR & 7'-0" AT UPPER FLOOR U.N.O.
29. GYPSUM BOARD ARCH @ 7'-2" TO 8'-0".
30. GYPSUM BOARD LOW WALL, 38" A.F.F. (U.N.O.) W/ MDF CAP.
31. SOFFIT, REFER TO EXTERIOR ELEVATIONS FOR HEIGHTS & ARCHITECTURAL DETAILS FOR FINISH.
32. PLANT SHELF, SEE EXTERIOR ELEVATIONS.
33. HALF WALL W/ WOOD CAP OR OPTIONAL LOW WALL WITH RAILING ABOVE.
34. PORCH RAIL, SEE ELEVATION.
35. 36"x36" CONCRETE STOOP.
36. 6x6 BEAM.
37. OPTIONAL UPPER CABINETS.
38. OPTIONAL CABINETS.
39. OPTIONAL COFFERED CEILING @ 8'-8" PER BUILDER SPEC.
40. LINE OF FRAMING ABOVE.
41. LINE OF FRAMING WALL BELOW.
42. NOT USED
43. 2X6 LOW WALL 42" A.F.F.
44. NOT USED
45. FOR ADDITIONAL NOTES SEE GENERAL NOTES ON TITLE SHEET & DETAILS.
46. ART NICHE
47. HORIZONTAL LAUNDRY CHUTE
48. LOW WALL +24" A.F.F.
49. GYPSUM BOARD ARCH @ 8'-0" TO 8'-6"
50. LOW WALL 32 1/4" A.F.F.

| SQUARE FOOTAGES "FRENCH COUNTRY" | |
|---|---|
| MAIN FLOOR | 2411 |
| UPPER FLOOR | 1798 |
| **SUBTOTAL** | **4209** |
| GARAGE | 482 |
| PORCH | 35 |
| OPT HOBBY ROOM | 278 |
| OPT SCREENED PORCH | 120 |
| **TOTAL** | **5121** |

ALL EXTERIOR HOUSE WALLS MAY BE OPTIONAL 2X6 STUD WALLS - SEE STRUCTURAL PLANS FOR DETAILS.

ISSUE DATE: 10/12/2012
REVISIONS


5400 Trinity Road
Suite 107
Raleigh,
North Carolina 27607
919-322-2285 Phone


Meritage Homes

BSB DESIGN
www.bsbdesign.com
6801 Westown Parkway, Suite 240
West Des Moines, Iowa 50266
515 273 3029


JOB NO:
DRAWN: HOUSTON
PROJ MGR:
CHECKED:

MAIN FLOOR PLAN - ELEVATION FRENCH COUNTRY

Plan 4230
**A2.1FC**

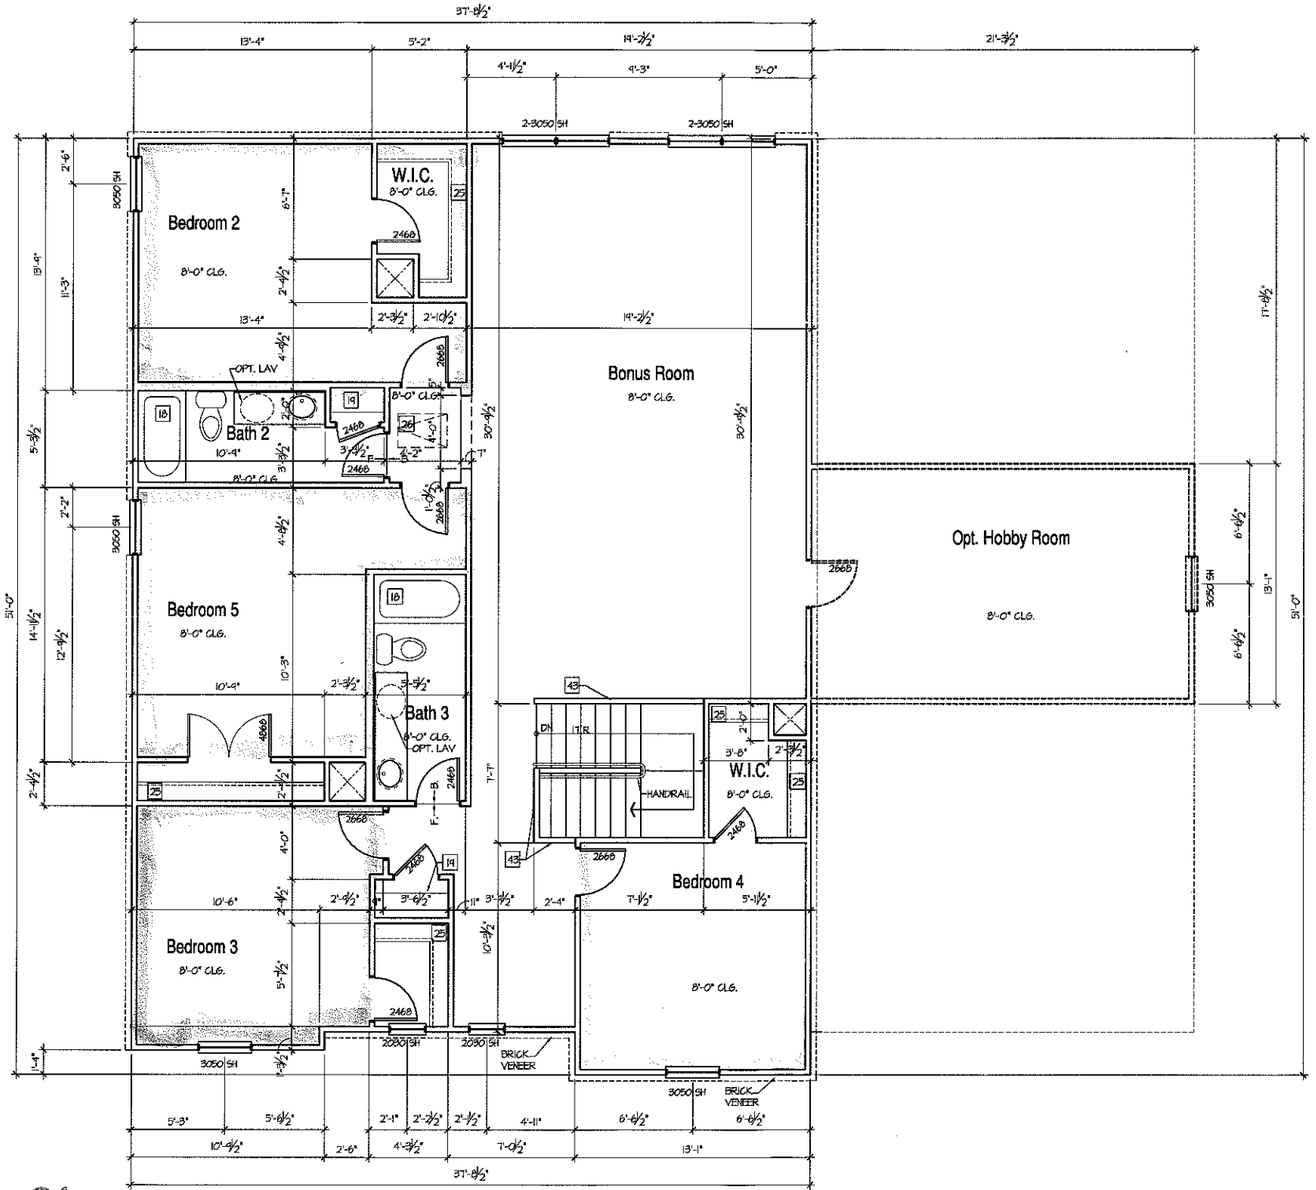


## Upper Floor Plan "C"

SCALE: 1/4"=1'-0"

ALL EXTERIOR HOUSE WALLS MAY BE OPTIONAL 2X6 STUD WALLS - SEE STRUCTURAL PLANS FOR DETAILS.

Acknowledgement Of Plans Submittal ONLY!

Date 11-14-12

Date 12-5-12

## TYPICAL CONSTRUCTION ASSEMBLIES:

A. TYPICAL ROOF CONSTRUCTION:
ASPHALT ROOF SHINGLES

B. TYPICAL FRAME FLOOR CONSTRUCTION:
FINISH FLOORING ON 3/4" TONGUE & GROOVE FLOOR SHEATHING ON FLOOR TRUSSES OR FLOOR JOISTS AS NOTED ON STRUCTURAL DRAWINGS.

C. SLAB ON GRADE FLOOR CONSTRUCTION:
4" CONCRETE SLAB, EXCEPT AS SPECIFIED BY SOIL REPORT, AND STRUCTURAL ENGINEER. INCLUDE VAPOR BARRIER PER SECTION IV, C, 3, a.

D. WINDOWS:
A. ALL WINDOWS SHALL COMPLY WITH MINIMUM STANDARDS OUTLINED IN APPLICABLE RES. CHECKS.
B. WINDOW SUPPLIER TO VERIFY AT LEAST ONE WINDOW IN ALL BEDROOMS TO HAVE A CLEAR EGRESS OPENING OF 5.7 SQ. FT. WITH MIN. DIMENSION OF 24" IN HEIGHT AND 20" IN WIDTH; SILL HEIGHT NOT GREATER THAN 44" ABOVE FLOOR.
C. TYPICAL WINDOW HEAD HEIGHT:
7'-0" A.F.F @ 8'-1 1/8" PLATE HEIGHT (U.N.O.)
8'-0" A.F.F @ 9'-1 1/8" PLATE HEIGHT (U.N.O.)

E. ELECTRICAL:
ALL ELECTRICAL AND MECHANICAL EQUIPMENT & METERS ARE SUBJECT TO RELOCATION DUE TO FIELD CONDITIONS; CONTRACTOR TO VERIFY.

F. HVAC:
PROVIDE BACK DRAFT DAMPERS @ DRYER VENT, HOOD VENT, & EXHAUST FANS.

G. STONE SIDING:
INSTALL PER LOCAL CODE.

H. DIMENSIONS ARE TO THE FACE OF STUD, U.N.O.

L. ALL EXTERIOR DIMENSIONS ARE TO FACE OF STUDS UNLESS OTHERWISE NOTED.

M. ALL ANGLED PARTITIONS ARE 45 DEGREES UNLESS OTHERWISE NOTED.

N. BRICK SIDING:
INSTALL PER LOCAL CODE.

## FLOOR PLAN NOTES:

[NOTE_FLOOR]

9 THE FOLLOWING KEYNOTES REFERENCE THE SYMBOLS AS SHOWN ON PLANS:

1. IF RAILING / GUARDRAIL IS PROVIDED, ALL RAILING / GUARDRAIL BALUSTERS TO BE SPACED SUCH THAT A 4" SPHERE CANNOT PASS BETWEEN BALUSTERS. RAILING/HANDRAILS ARE TO BE AT A 34" MINIMUM TO 38" MAXIMUM HEIGHT A.F.F., WITH RETURNS PER LOCAL CODE. RAILING AT GUARDRAIL LOCATIONS TO BE AT 42" MINIMUM A.F.F. OPT. RAILING.
2. LINE OF OVERHEAD GARAGE DOOR IN OPEN POSITION.
3. NOT USED
4. SLOPE GARAGE FLOOR 1/8" PER FOOT TOWARD OVERHEAD GARAGE DOOR OPENING.
5. FIREPLACE, AS SPECIFIED BY BUILDER. INSTALL PER MANUFACTURERS SPECIFICATIONS. ALL FACTORY BUILT FIREPLACES SHALL COMPLY WITH LOCAL CODES
6. NOT USED
7. SINK W/ GARBAGE DISPOSAL
8. DISHWASHER
9. RANGE
10. COOK TOP
11. OVEN
12. REFRIGERATOR SPACE.
13. PANTRY
14. PEDESTAL SINK
15. NOT USED
16. 36"x48" SHOWER
17. 42"x60" TUB
18. 32" X 60" TUB
19. LINEN
20. WASHER SPACE
21. DRYER VENT
22. OPTIONAL LAUNDRY SINK.
23. PROVIDE NON-COMBUSTIBLE PLATFORM ELEVATED 18" ABOVE GARAGE FLOOR FOR WATER HEATER.
24. NOT USED
25. SHELVING PER BUILDER SPECS.
26. ATTIC ACCESS (22"x32" U.N.O.).
27. ATTIC ACCESS W/ STAIRS (22 1/2"x54" U.N.O.).
28. GYPSUM BOARD OPENING @ 8'-0" AT MAIN FLOOR & 7'-0" AT UPPER FLOOR U.N.O.
29. GYPSUM BOARD ARCH @ 7'-2" TO 8'-0".
30. GYPSUM BOARD LOW WALL, 38" A.F.F. (U.N.O.) W/ MDF CAP.
31. SOFFIT, REFER TO EXTERIOR ELEVATIONS FOR HEIGHTS & ARCHITECTURAL DETAILS FOR FINISH.
32. PLANT SHELF, SEE EXTERIOR ELEVATIONS.
33. HALF WALL W/ WOOD CAP OR OPTIONAL LOW WALL WITH RAILING ABOVE.
34. PORCH RAIL, SEE ELEVATION.
35. 36"x36" CONCRETE STOOP.
36. 6x8 BEAM.
37. OPTIONAL UPPER CABINETS.
38. OPTIONAL CABINETS.
39. OPTIONAL COFFERED CEILING @ 8'-8" PER BUILDER SPEC.
40. LINE OF FRAMING ABOVE.
41. LINE OF FRAMING WALL BELOW.
42. NOT USED
43. 2X6 LOW WALL 42" A.F.F.
44. NOT USED
45. FOR ADDITIONAL NOTES SEE GENERAL NOTES ON TITLE SHEET & DETAILS.
46. ART NICHE
47. HORIZONTAL LAUNDRY CHUTE
48. LOW WALL +24" A.F.F.
49. GYPSUM BOARD ARCH @ 8'-0" TO 8'-6"
50. LOW WALL 32½" A.F.F.

ISSUE DATE: 10/12/2012

REVISIONS

THESE PLANS AND SPECIFICATIONS ARE PROTECTED UNDER THE COPYRIGHT LAWS OF THE UNITED STATES AND THE DESIGNER OF RECORD HAS ALL RIGHTS AND PRIVILEGES.

5400 Trinity Road
Suite 107
Raleigh,
North Carolina 27607
919-322-2285 Phone

Meritage Homes

BSB DESIGN
www.bsbdesign.com
6801 Westown Parkway, Suite 240
West Des Moines, Iowa 50266
515 273 9020

JOB NO: PROJ MGR:
DRAWN: HOUSTON CHECKED: --

UPPER FLOOR PLAN -
ELEVATION FRENCH COUNTRY

Plan 4230

**A3.1FC**