IREDELL COUNTY HEALTH DEPARTMENT

STATESVILLE 704-878-5305 MOORESVILLE 704-664-5281

IMPROVEMENT PERMIT / AUTHORIZATION TO CONSTRUCT / OPERATION PERMIT / EXISTING SYSTEM INSPECTION

PERMIT # 152407 PIN # 4639-83-4095.068 4639-84-2960 DATE 11-18-08

OWNER or APPLICANT RYAN WEST DEVELOPERS PHONE: Business 704-361-1084 Home:

OWNER or APPLICANT ADDRESS 127 B PROMENADE DR MOORESVILLE NC 28117

LOCATION / DIRECTIONS CORNELIUS RD, TR JUDAS, TR PERTH, BELLS CROSSING ON L

SUBDIVISION BELLS CROSSING BLOCK / SECTION LOT # 68 LOT AREA .87AC DESIGN FLOW 480 L.T.A.R. .275

Septic Tank 1000 Gallons: STB 60 Date 1-27
Pump Tank Gallons: P T Date
Pump Make Model Serial #
Nitrification Field No Fields 1 No Lines 4 Linear Feet 440'
Trench Width 36" Max. Trench Bottom Depth 36" Gravel Depth —

☒ New System ☐ Repair ☐ Expansion System Type I II III IV V VI
System Description: GRAVITY 25% RED
Repair System Description: LP - PANEL BLOCK
Maintenance Agreement Required ☐ YES ☒ NO INITIALLY
☒ GRAVITY ☐ PRESSURE


☒ Residence No. Bedrooms 4
☐ Business No. Persons 8
☐ Other No. Employees
☐ Slab ☒ Crawl Space
☐ Basement w/plumbing ☐ Basement w/o plumbing

Water Supply: ☐ Private ☐ Public ☒ Community


Comments / Conditions 1) INSTALL PER PLAN SPECS BY ROLLINS SOIL & ENV. SERVICES

Comments / Conditions

INITIAL SITE SKETCH

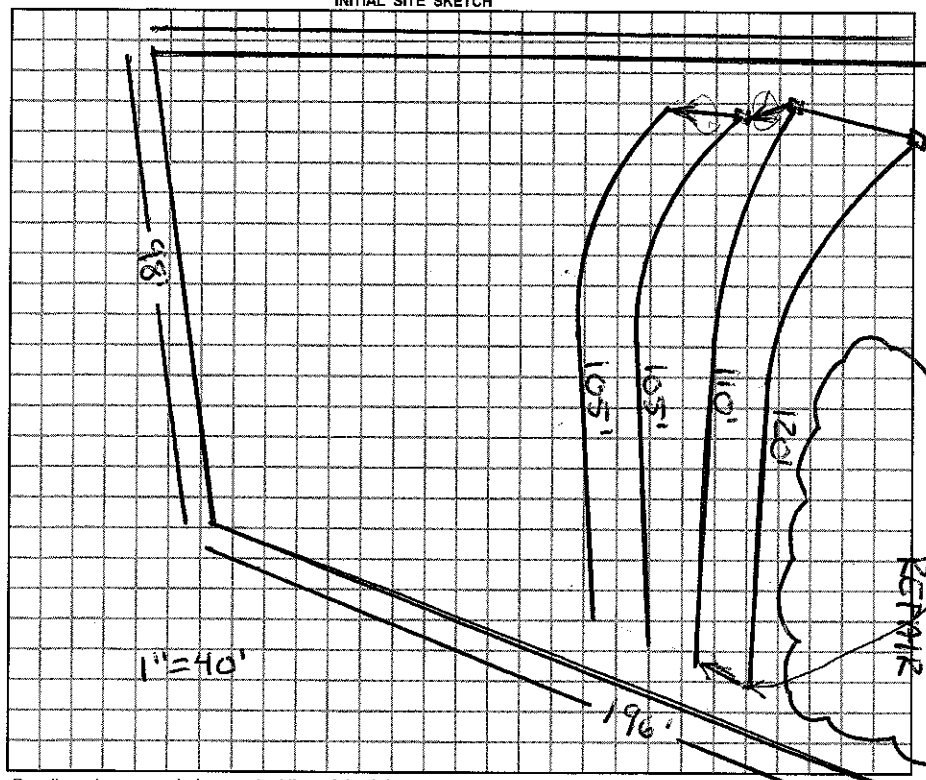

AS BUILT SKETCH

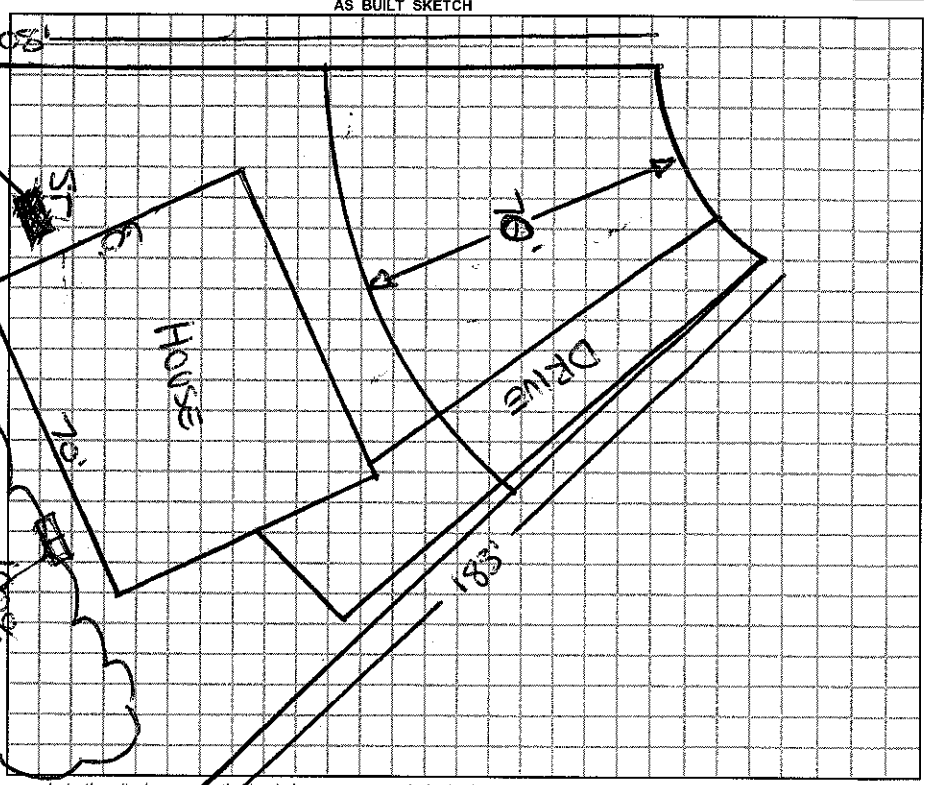

Permit can be suspended or revoked if any false information is supplied toward securing the permit / any unauthorized changes are made to the site / any unauthorized changes are made in the installation of the system.

☐ *IMPROVEMENT PERMIT w / plat valid without expiration.* ☒ *IMPROVEMENT PERMIT w / site plan valid for 60 mos.* ☒ *AUTHORIZATION TO CONSTRUCT valid for period equal to IMPROVEMENT PERMIT-not to exceed 60 mo.*

Owner / Applicant Signature Date 12/16/08

Improvement Permit by: Date 11-18-08

Authorization to Construct by: Date 2/13/13

YOU SHOULD CONTACT A LOCATOR SERVICE PRIOR TO ANY EXCAVATION.

Installed by:

Operation Permit by: Date: 6-24-13

Existing System Inspected by: Date:

WHITE COPY Environmental Health YELLOW COPY (Final) Owner / Applicant PINK COPY (Initial) Owner / Applicant