IREDELL COUNTY HEALTH DEPARTMENT

STATESVILLE 704-878-5305 ☑ MOORESVILLE 704-664-5281

IMPROVEMENT PERMIT / AUTHORIZATION TO CONSTRUCT / OPERATION PERMIT / EXISTING SYSTEM INSPECTION

PERMIT # 152017 PIN # 4639-84-4220 DATE 11-7-12

OWNER or APPLICANT MERITAGE HOMES PHONE: Business 704-351-5405 Home:

OWNER or APPLICANT ADDRESS 7761 BALLANTYNE COMMONS PKWY

LOCATION / DIRECTIONS PERTH, TI BELLS CROSSING, TL BELFRY, ON R

SUBDIVISION BELLS CROSSING BLOCK / SECTION LOT # 205 LOT AREA .67AC DESIGN FLOW 600 L.T.A.R. .225

Septic Tank ☑1500 Gallons: STB 944 Date

Pump Tank ☑~~1000~~1500 Gallons: PT 1003 Date

Pump Make ZOELLER Model N-152 Serial #

Nitrification Field No Fields 1 No Lines 6 Linear Feet 704'

Trench Width 36" Max. Trench Bottom Depth ☑33" Gravel Depth —

☑ New System ☐ Repair ☐ Expansion System Type I II (III)B IV V VI

System Description: PM 25% RED.

Repair System Description: LP PANEL BLOCK

Maintenance Agreement Required ☐ YES ☑ NO

☐ GRAVITY ☑ PRESSURE

☑ Residence No. Bedrooms 5 ☐ Private

☐ Business No. Persons ☐ Public

☐ Other No. Employees ☑ Community

☑ Slab ☐ Crawl Space

☐ Basement w/plumbing ☐ Basement w/o plumbing


Water Supply

Comments / Conditions ① MAINTAIN ALL REQUIRED SETBACKS


② SEE DIFFERING TAP SIZES

Comments / Conditions

INITIAL SITE SKETCH

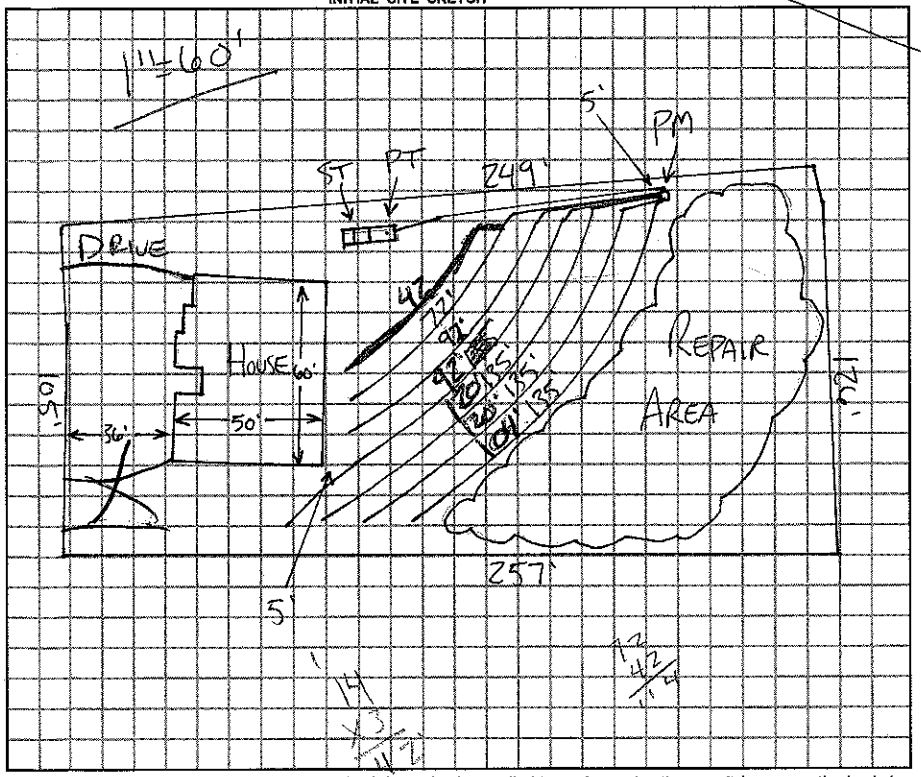

AS BUILT SKETCH

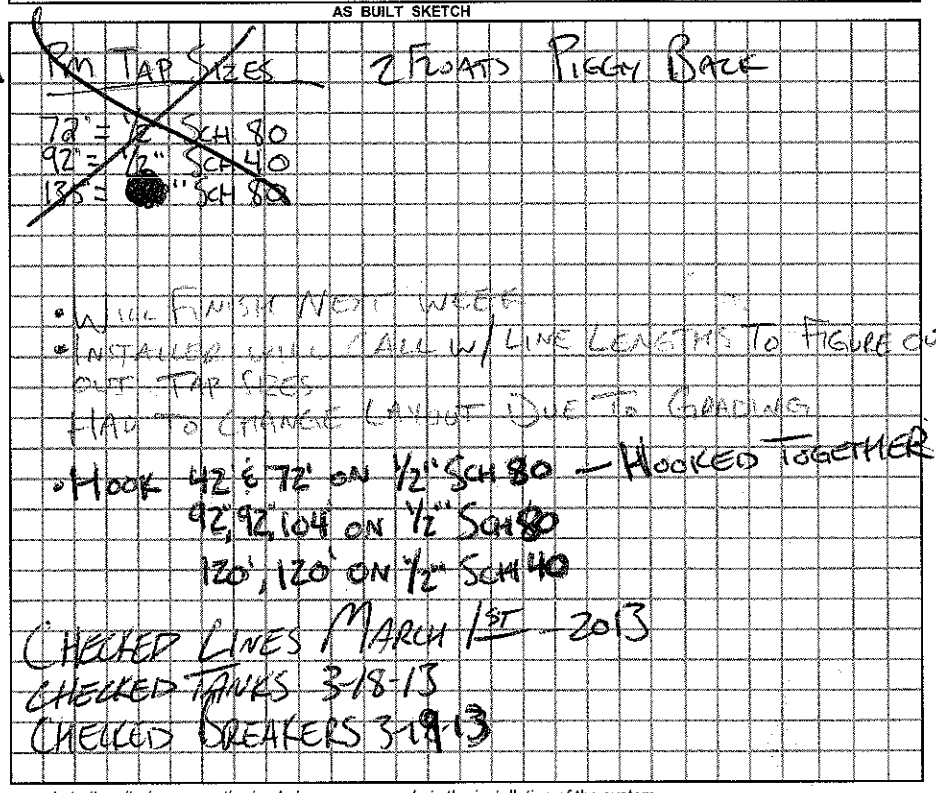

Permit can be suspended or revoked if any false information is supplied toward securing the permit / any unauthorized changes are made to the site / any unauthorized changes are made in the installation of the system.

☐ *IMPROVEMENT PERMIT w / plat valid without expiration.* ☑ *IMPROVEMENT PERMIT w / site plan valid for 60 mos.* ☑ *AUTHORIZATION TO CONSTRUCT valid for period equal to IMPROVEMENT PERMIT-not to exceed 60 mo.*

Owner / Applicant Signature: [signature] Date 11-14-12

Improvement Permit by: [signature] Date 11-7-12

Authorization to Construct by: [signature] Date 11-14-12

Installed by: CAROLINA PIPE CLEANING

Operation Permit by: [signature] Date: 3-19-13

Existing System Inspected by: Date:

YOU SHOULD CONTACT A LOCATOR SERVICE PRIOR TO ANY EXCAVATION.

WHITE COPY Environmental Health YELLOW COPY (Final) Owner / Applicant PINK COPY (Initial) Owner / Applicant