IREDELL COUNTY HEALTH DEPARTMENT

Statesville Office (704) 878-5305 Mooresville Office (704) 660-3625 PERMIT # 152404

IMPROVEMENT PERMIT / AUTHORIZATION TO CONSTRUCT / OPERATION PERMIT / EXISTING SYSTEM

PIN # 4639847872

APPLICANT: MERITAGE HOMES APPLICANT ADDRESS: 7761 BALLANTYNE COMMONS PKWY

SITE ADDRESS: 184 BELLS CROSSING DR. PHONE: ALT. PHONE:

SITE DIRECTIONS: PERTH, TL BELLS CROSSING, ON R

SUBDIVISION: BELLS CROSSING SECTION: LOT # 63 LOT AREA: DESIGN FLOW: 600 L.T.A.R.: .3

Septic Tank 1500 (gal) STB 9104 Date 7-7
Pump Tank (gal) PT Date
Pump Make Model Serial #
Nitrification Fields 1 # Lines 8 Linear Ft: 500
Trench Width 36" Max. Trench Bottom Depth 36" Gravel Depth —


☒ New System ☐ Repair ☐ Expansion System Type: I II ☒ III IV V VI
System Description: 25% REDUCTION
Repair System Description: LP- PANEL
Maintenance Agreement Required: ☐ YES ☒ NO
☒ GRAVITY ☐ PRESSURE

☒ Residence No. Bedrooms 5
☐ Business No. Persons
☐ Other No. Employees
☒ Slab ☐ Crawl Space
☐ Basement w/plumbing ☐ Basement w/o plumbing

Water Supply: ☐ Private ☐ Public ☒ Community

Comments / Conditions:

INITIAL SITE SKETCH

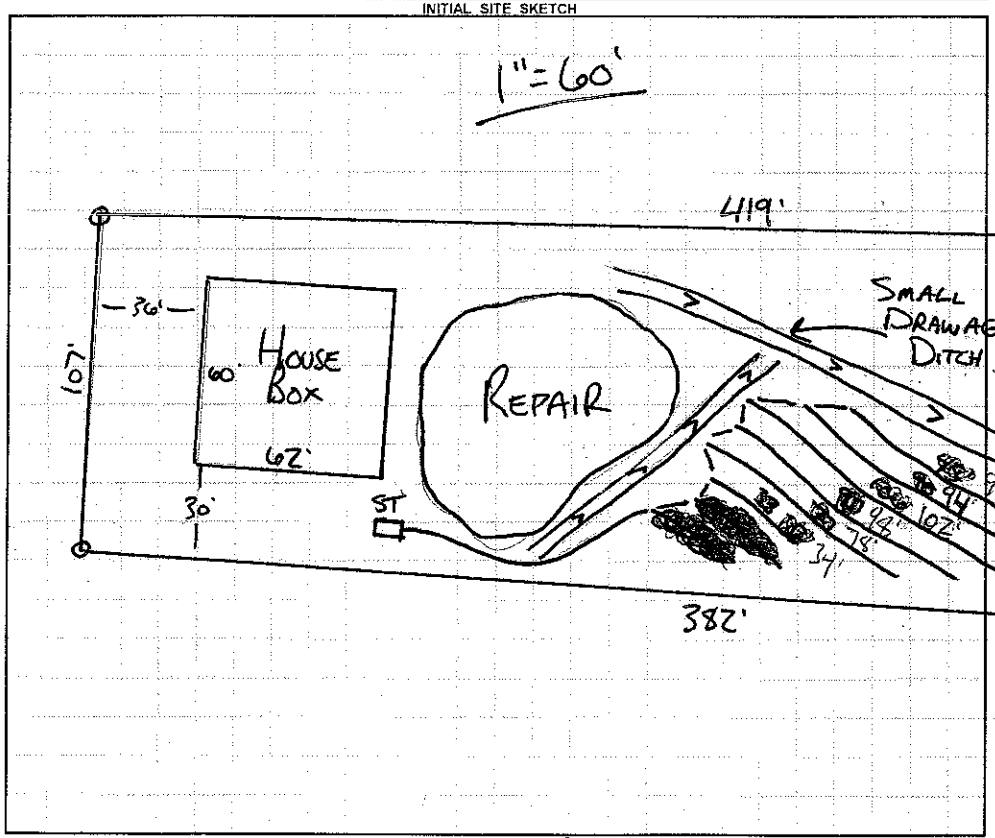

AS BUILT SKETCH

CHECKED BOTTOM 3 LINES 9-10-13
CHECKED TOP 3 LINES 9-11-13
CHECK TANKS 9-12-13

Permit can be suspended or revoked if any false information is supplied toward securing the permit / any unauthorized changes are made to the site / any unauthorized changes are made in the installation of the system. **CONTACT A LOCATOR SERVICE PRIOR TO ANY EXCAVATION**

☐ **IMPROVEMENT PERMIT** *with plat valid without expiration* ☐ **IMPROVEMENT PERMIT** *with site plan valid for 60 mos.* ☒ **AUTHORIZATION TO CONSTRUCT** *valid for period equal to IMPROVEMENT PERMIT--not to exceed 60 mo.*

Owner / Applicant Signature: Date: 4-19-13 Installed by:

IMPROVEMENT PERMIT by: Date: 1-2-13 OPERATION PERMIT by: Date: 9-12-13

AUTHORIZATION TO CONSTRUCT by: Date: 1-2-13 Existing System Inspected by: Date:

Health Dept. Copy - WHITE Applicant (Final Approval) - YELLOW Applicant (Conditional Approval) - PINK