IREDELL COUNTY HEALTH DEPARTMENT

Statesville Office (704) 878-5305 — Mooresville Office (704) 660-3625 — PERMIT # 214552

IMPROVEMENT PERMIT / AUTHORIZATION TO CONSTRUCT / OPERATION PERMIT / EXISTING SYSTEM

PIN # 4639-84-8777

APPLICANT: TYLER BROWN — APPLICANT ADDRESS: 178 BELLS CROSSING DR.

SITE ADDRESS: SAME — PHONE: 847-903-4420 — ALT. PHONE:

SITE DIRECTIONS: PERTH, TL BELLS, ON R


SUBDIVISION: BELLS CROSSING — SECTION: 1 — LOT # 62 — LOT AREA: .93 AC — DESIGN FLOW: 600 — L.T.A.R.: .25 (.225R)

Septic Tank	1500 (gal)	STB	Date	☐ New System	☑ Repair	☐ Expansion	System Type: I II (III) IV V VI	☑ Residence	No. Bedrooms 5
Pump Tank	(gal)	PT	Date	System Description:				☐ Business	No. Persons
Pump Make	Model		Serial #	Repair System Description:	TANK REPLACEMENT			☐ Other	No. Employees
# Nitrification Fields	# Lines		Linear Ft:	Maintenance Agreement Required:	☐ YES	☑ NO		☑ Slab	[redacted]
Trench Width	Max. Trench Bottom Depth	EXISTING	Gravel Depth —		☑ GRAVITY	☐ PRESSURE		☐ Basement w/plumbing	☐ Basement w/o plumbing


Water Supply: ☐ Private ☐ Public ☑ Community

Comments / Conditions: PUMP, CRUSH & FILL OLD TANK. INSTALL NEW 1500 GAL TANK 10' FROM PROPERTY LINE AS SHOWN

INITIAL SITE SKETCH

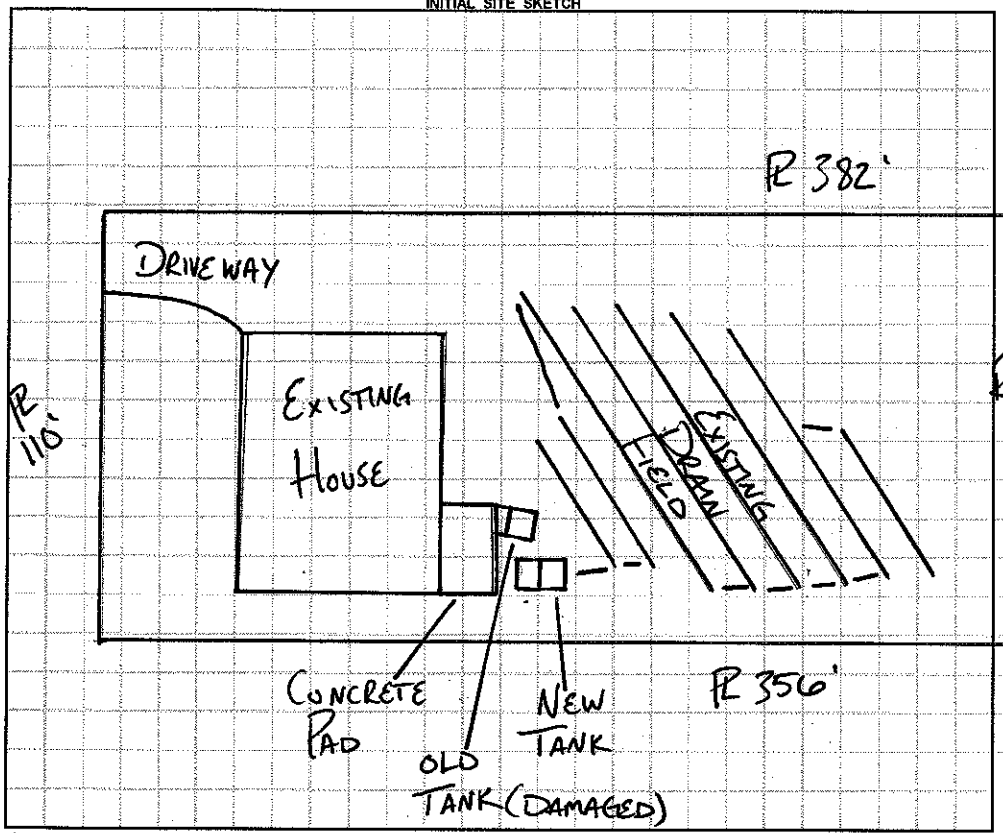

AS BUILT SKETCH

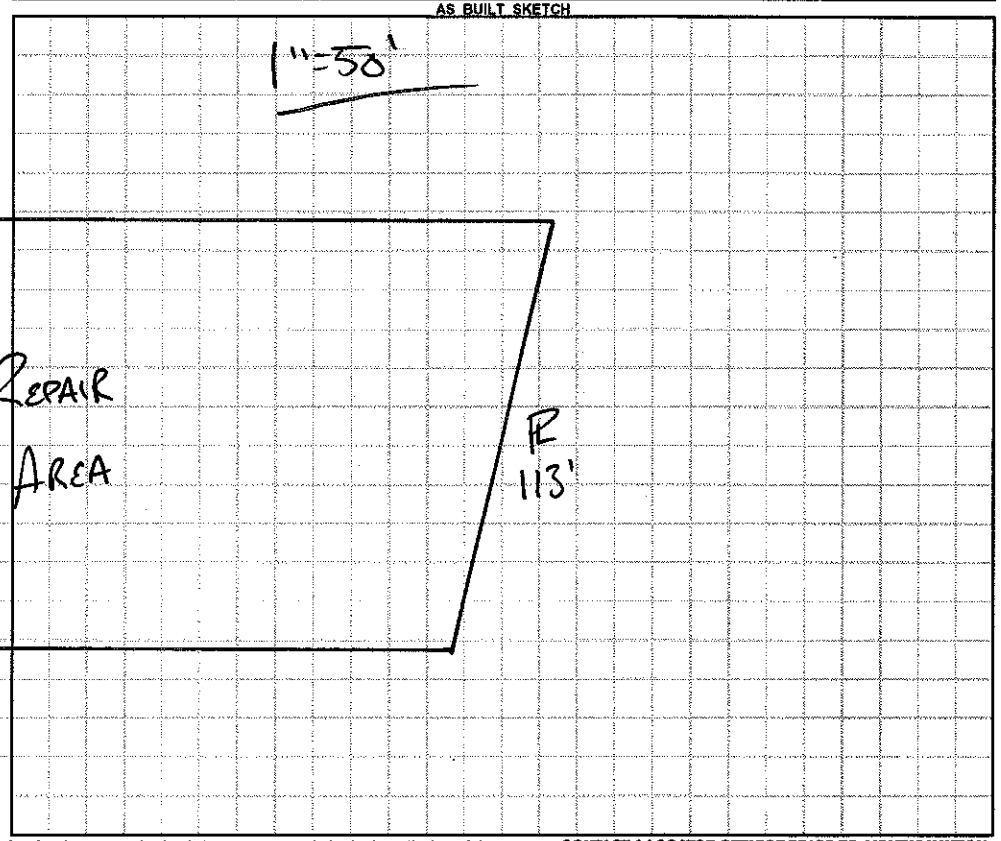

Permit can be suspended or revoked if any false information is supplied toward securing the permit / any unauthorized changes are made to the site / any unauthorized changes are made in the installation of the system. **CONTACT A LOCATOR SERVICE PRIOR TO ANY EXCAVATION**

☐ **IMPROVEMENT PERMIT** *with plat valid without expiration.* ☐ **IMPROVEMENT PERMIT** *with site plan valid for 60 mos.* ☑ **AUTHORIZATION TO CONSTRUCT** *valid for period equal to IMPROVEMENT PERMIT--not to exceed 60 mo.*

Owner / Applicant Signature: Thomas Brown — Date: 11/10/15 — Installed by: CPC

IMPROVEMENT PERMIT by: BA — Date: APPROVED NOV 02 2015 — OPERATION PERMIT by: BA — Date: 11-12-15

AUTHORIZATION TO CONSTRUCT by: BA — Date: APPROVED NOV 02 2015 — Existing System Inspected by: — Date:

Health Dept. Copy - WHITE Applicant (Final Approval) - YELLOW Applicant (Conditional Approval) - PINK