IREDELL COUNTY HEALTH DEPARTMENT

STATESVILLE 704-878-5305 ✓MOORESVILLE 704-664-5281

IMPROVEMENT PERMIT / AUTHORIZATION TO CONSTRUCT / OPERATION PERMIT / EXISTING SYSTEM INSPECTION

PERMIT # 152403 PIN # 4639-84-8777 DATE 11-29-12

OWNER or APPLICANT MERITAGE HOMES PHONE: Business 704-351-5405 Home: GERALD BOSWELL

OWNER or APPLICANT ADDRESS 7761 BALLANTYNE COMMONS PKWY

LOCATION / DIRECTIONS PERTH, TL BELLS CROSSING, ON R

SUBDIVISION BELLS CROSSING BLOCK / SECTION LOT # 62 LOT AREA .93AC DESIGN FLOW 600 L.T.A.R. .25 (.225R)

Septic Tank 1500 Gallons: STB 2039 Date FRALO TANK

Pump Tank Gallons: P T Date

Pump Make Model Serial #

Nitrification Field No Fields 1 No Lines 8 Linear Feet 604'

Trench Width 36" Max. Trench Bottom Depth 36" Gravel Depth —

☒ New System ☐ Repair ☐ Expansion System Type I II (III) IV V VI

System Description: 25% REDUCTION

Repair System Description: PANEL BLOCK

Maintenance Agreement Required ☐ YES ☒ NO

☒ GRAVITY ☐ PRESSURE

☒ Residence No. Bedrooms 5 ☐ Business No. Persons ☐ Other No. Employees

☒ Slab ☐ Crawl Space ☐ Basement w/plumbing ☐ Basement w/o plumbing


Water Supply: ☐ Private ☐ Public ☒ Community

Comments / Conditions


LOOK FOR PERMITS

Comments / Conditions

INITIAL SITE SKETCH

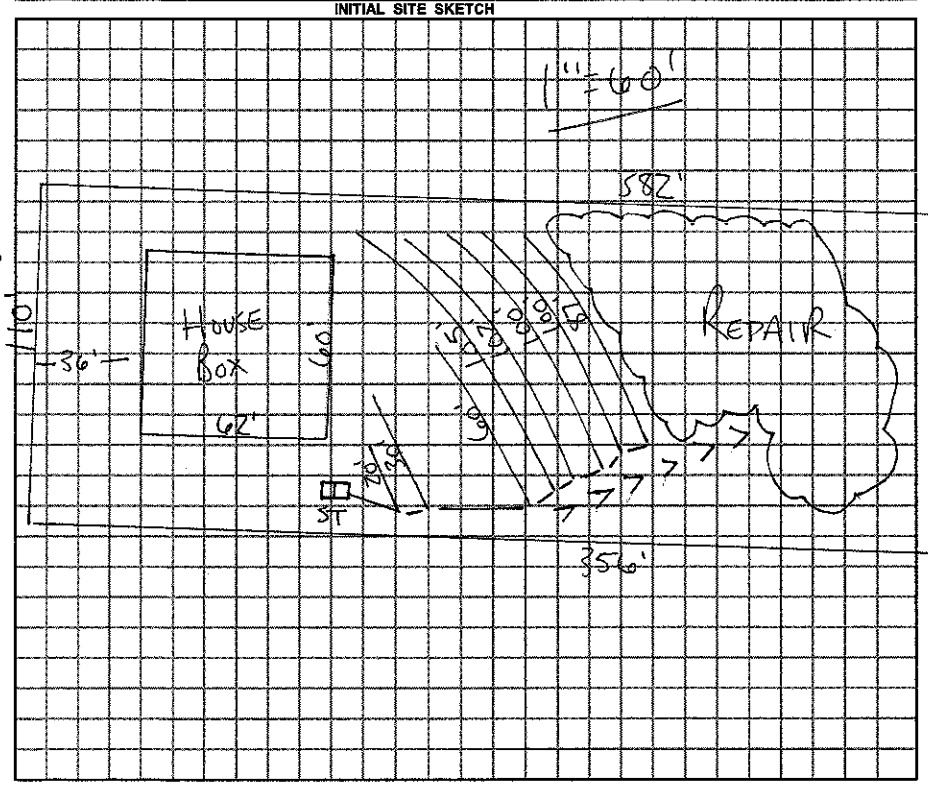

AS BUILT SKETCH

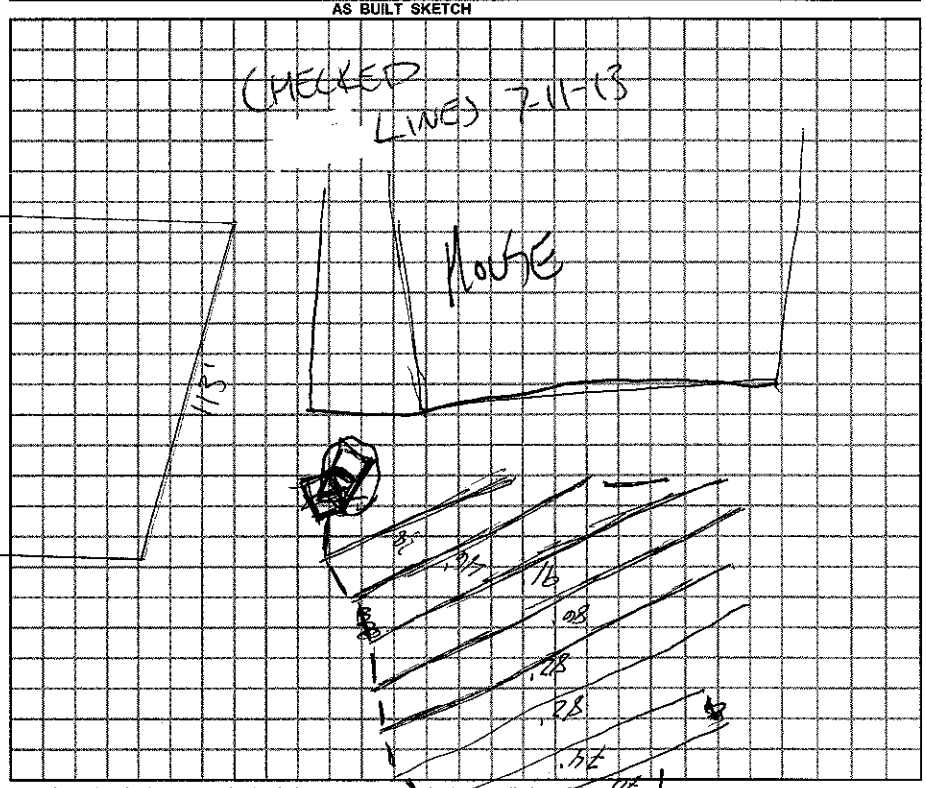

Permit can be suspended or revoked if any false information is supplied toward securing the permit / any unauthorized changes are made to the site / any unauthorized changes are made in the installation of the system.

☐ *IMPROVEMENT PERMIT w / plat valid without expiration.* ☒ *IMPROVEMENT PERMIT w / site plan valid for 60 mos.* ☒ *AUTHORIZATION TO CONSTRUCT valid for period equal to IMPROVEMENT PERMIT-not to exceed 60 mo.*

Owner / Applicant Signature: [signature] Date 12-6-12

Improvement Permit by: [signature] Date 11-29-12

Authorzation to Construct by: [signature] Date 11-29-12

Installed by: [signature]

Operation Permit by: [signature] Date: 7-30-13

Existing System Inspected by: Date:

YOU SHOULD CONTACT A LOCATOR SERVICE PRIOR TO ANY EXCAVATION.

WHITE COPY Environmental Health YELLOW COPY (Final) Owner / Applicant PINK COPY (Initial) Owner / Applicant