IREDELL COUNTY HEALTH DEPARTMENT

STATESVILLE 704-878-5305 MOORESVILLE 704-664-5281

IMPROVEMENT PERMIT / AUTHORIZATION TO CONSTRUCT / OPERATION PERMIT / EXISTING SYSTEM INSPECTION

PERMIT# 132176 PIN# 4639 75 9458 4639850587 New Pin DATE 7/24/07

OWNER OR APPLICANT Americas Homeplace Inc. PHONE: Business 704-664-5800 Home

ADDRESS 168 D Norman Station Blvd. Mooresville, NC. 28117

LOCATION Perth. N To Fern Hill To Creekwood Village TR Duvall Ct. lot on (L) Corner

SUBDIVISION Creekwood Hills BLOCK / SECTION LOT 45 & 46 LOT AREA 1.425 SITE CLASS. PS DESIGN FLOW 360 L.T.A.R. 3

Septic Tank: 1000 Gallons; STB 821 Date 8-7-07
Pump Tank: 1000 Gallons; PT 40 Date 7-30-07
Pump Make: Zoeller Model N53 Serial No.
Nitrification Field: No Fields 1 Square Feet 600 Linear Feet 200
No Lines 4@50' Trench Width 2-3' Max Trench Bottom Depth 3' Gravel Depth NA

☒ New System ☐ Repair ☐ Expansion System Type: I II III IV V VI
System Description: Pressure 16" PPBPS
Repair System Description: Same
Maintenance Agreement Required: ☐ Yes ☒ No Aerobic

☒ House/Mod. Home No. Bedrooms 3
☐ Mobile Home No. Persons
☐ Business No. Employees
☐ Other

Water Supply: ☒ Individual ☐ Public ☐ Community


☐ Gravity ☒ Pressure ☐ Slab ☐ Crawl Space ☒ Basement w/plumbing ☐ Basement wo/plumbing

1/3 HP

Comments/Conditions:

(1" = 60')

INITIAL SITE SKETCH

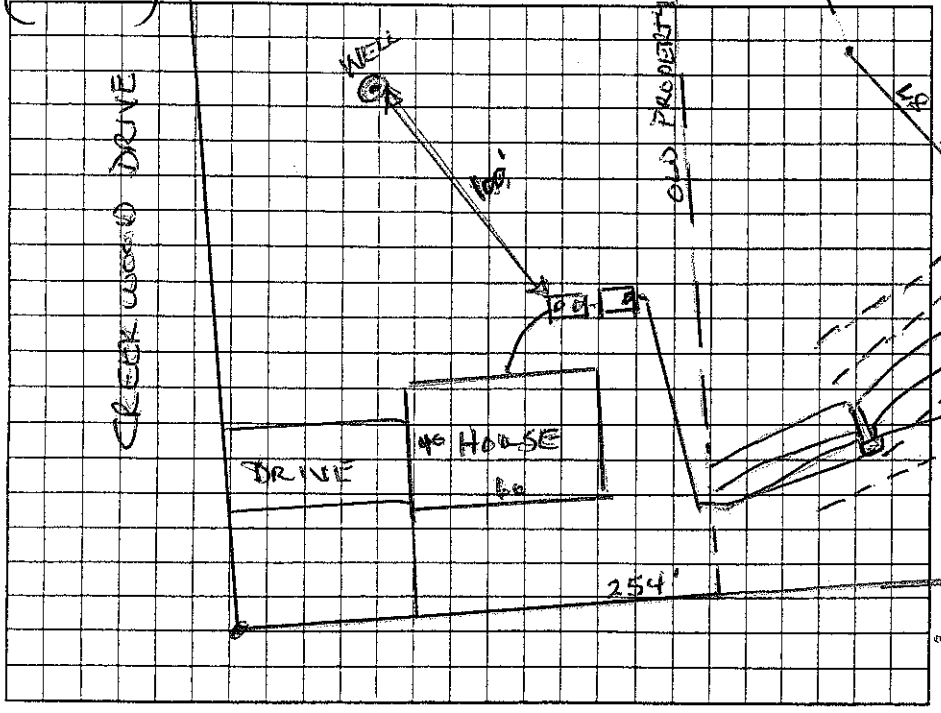


Comments/Conditions:

PM → 16" PPBPS MAY BE INSTALLED.

Yellow tuf-tite filter

AS BUILT SKETCH

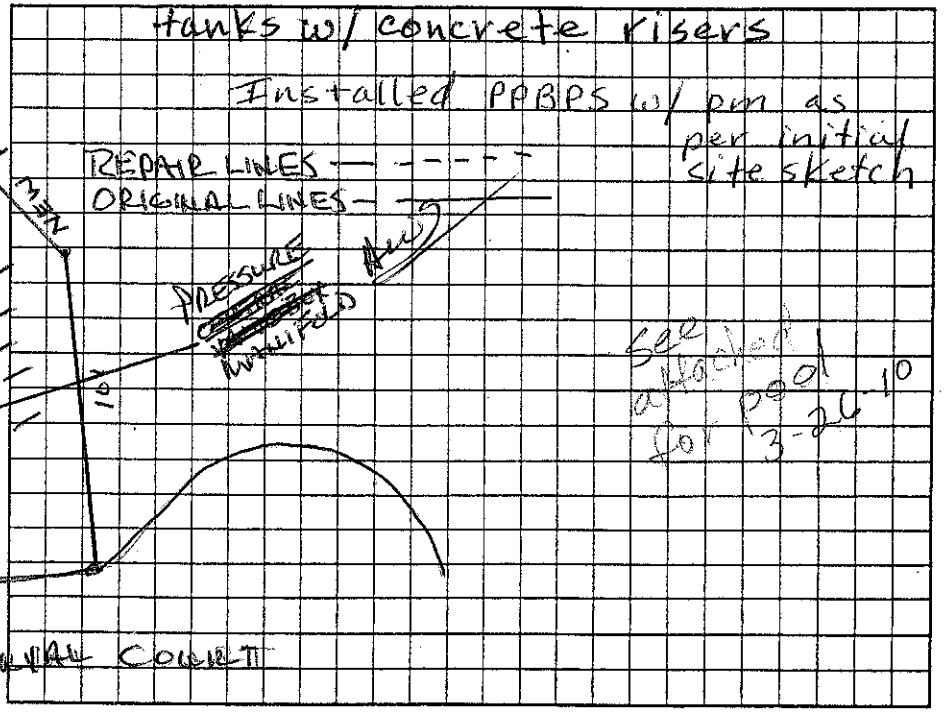

Permit can be suspended or revoked if any false information is supplied toward securing the permit/any unauthorized changes are made to the site/any unauthorized changes are made in the installation of the system. Improvement Permit with plat valid without expiration ☐ Improvement Permit with site plan valid for sixty months ☐ Authorization to Construct is valid for a period equal to that of Improvement Permit – not to exceed sixty months.

Signed: Chad Fuller date 7/25/07

Improvement Permit by: Wesley Sparks RS. date 7/24/07

Authorization to Construct by: Wesley Sparks RS date 7/24/07

Installed by: Ray's Septic

Operation Permit by: Judy Merritt date 11-13-07

Existing System Inspection by: date

HEALTH DEPT. COPY: WHITE OWNER COPY (FINAL): YELLOW OWNER COPY (INITIAL): PINK