# IREDELL COUNTY HEALTH DEPARTMENT

STATESVILLE 704-878-5305 MOORESVILLE 704-664-5281

## IMPROVEMENT PERMIT / AUTHORIZATION TO CONSTRUCT / OPERATION PERMIT / EXISTING SYSTEM INSPECTION

PERMIT# 132176 PIN# 4639 75 9458 DATE 7/24/07

OWNER OR APPLICANT American Homeplex Hms. PHONE: Business 704-664-5800 Home

ADDRESS 1128 D Norman Station Blvd. Mooresville, NC. 28117

LOCATION Perth Rd To Fun Hill Tr To Creekwood Valley Tr Dunall Ct. lot on (L) corner

SUBDIVISION Creekwood Valley BLOCK / SECTION LOT 46 LOT AREA 1.425 SITE CLASS. PS DESIGN FLOW 360 L.T.A.R. .3

Septic Tank: 1000 Gallons; STB 821 Date 8-7-07

Pump Tank: 1000 Gallons; PT 40 Date 7-30-07

Pump Make: Zoeller Model N53 Serial No.

Nitrification Field: No Fields 1 Square Feet 600 Linear Feet 200

No Lines 4 @ 0.50' Trench Width 2-3' Max Trench Bottom Depth 3' Gravel Depth NA

☒ New System ☐ Repair ☐ Expansion System Type: I II III IV V VI

System Description: Pump tank w/ PAPS

Repair System Description: Same

Maintenance Agreement Required: ☐ Yes ☒ No Aug 5

☒ House/Mod. Home No. Bedrooms 3

☐ Mobile Home No. Persons

☐ Business No. Employees

☐ Other

Water Supply: ☒ Individual ☐ Public ☐ Community

☐ Gravity ☒ Pressure ☐ Slab ☐ Crawl Space ☒ Basement w/plumbing ☐ Basement w/o plumbing

Comments/Conditions:


Comments/Conditions:

PM → 16' PAPS MAY BE INSTALLED. 4 lines


Yellow Sulfa-tite filter

INITIAL SITE SKETCH

(1" = 60')

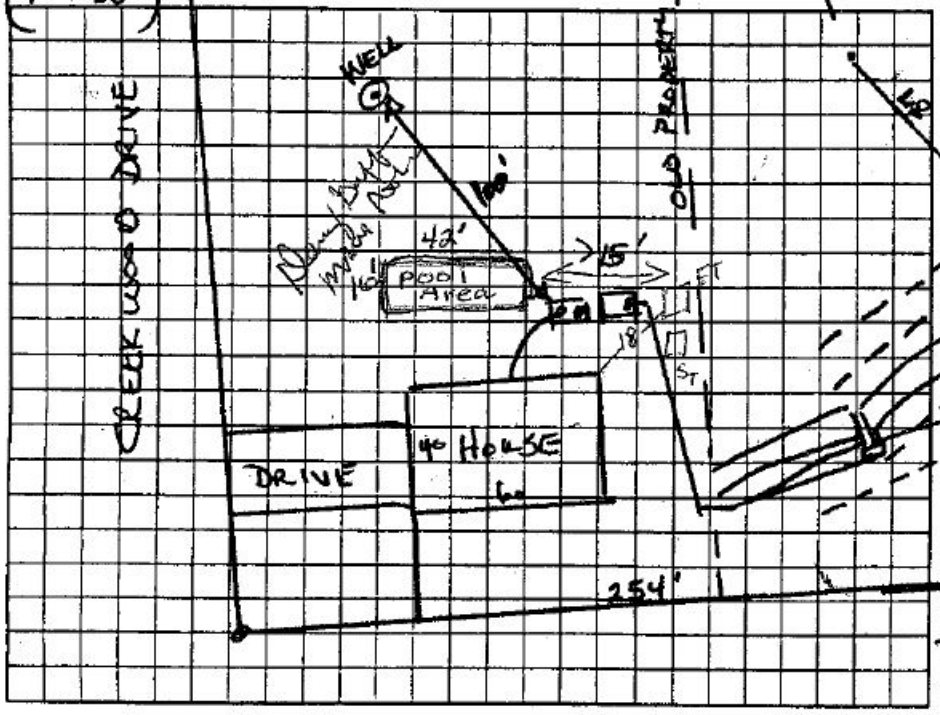


AS BUILT SKETCH

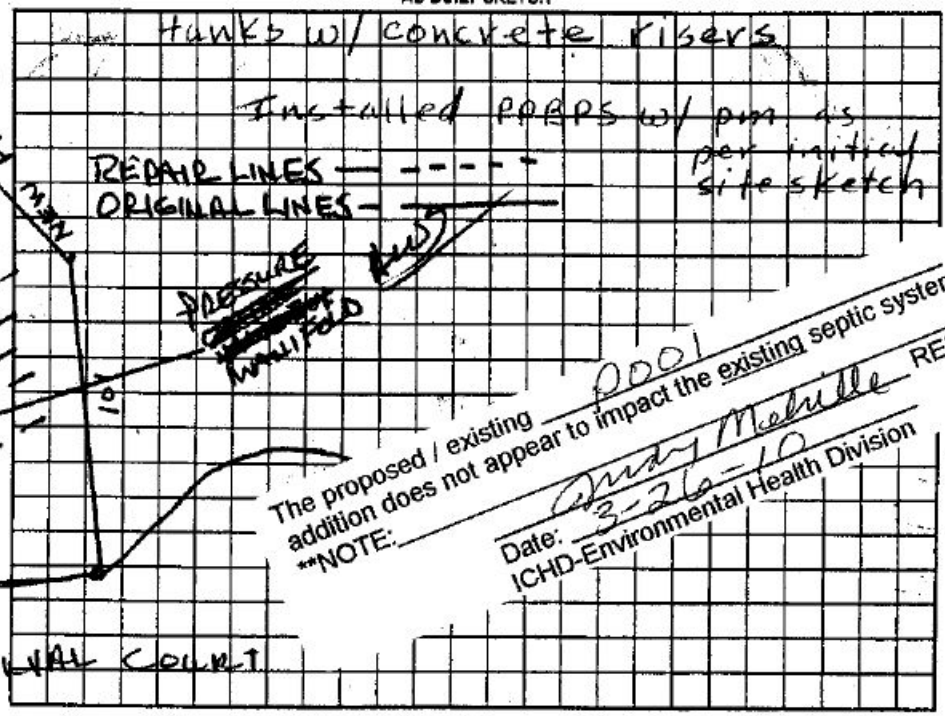


The proposed / existing 0001 addition does not appear to impact the existing septic system.

**NOTE:

Date: 3-26-10 ICHD-Environmental Health Division REHS

Permit can be suspended or revoked if any false information is supplied toward securing the permit/any unauthorized changes are made to the site/any unauthorized changes are made in the installation of the system. Improvement Permit with plat valid without expiration ☐ Improvement Permit with site plan valid for sixty months ☐ Authorization to Construct is valid for a period equal to that of Improvement Permit – not to exceed sixty months.

Signed: J. Quad Heller date 7/26/07

Improvement Permit by: Wesley Sparks RS. date 7/24/07

Authorization to Construct by: Wesley Sparks RS date 7/24/07

Installed by: Ray's Septic

Operation Permit by: Andy Melville date 11-13-07

Existing System Inspection by: date

HEALTH DEPT. COPY: WHITE OWNER COPY (FINAL): YELLOW OWNER COPY (INITIAL): PINK