IREDELL COUNTY HEALTH DEPARTMENT

STATESVILLE 704-878-5305 MOORESVILLE 704-664-5281

IMPROVEMENT PERMIT / AUTHORIZATION TO CONSTRUCT / OPERATION PERMIT / EXISTING SYSTEM INSPECTION

PERMIT# 109471 PIN# 4639-85-2790 DATE June 6, 03

OWNER OR CONTRACTOR Corinthian Development PHONE: Business _____ Home _____

ADDRESS P.O. Box 990 Denver N.C. 28037

LOCATION ISOW TR Perth RD. (N.) TL Fern Hill TL Creekwood on left at end

SUBDIVISION CREEKWOOD BLOCK / SECTION 2 LOT 47 29 LOT AREA 1.246 AC SITE CLASS. B pre 1957 DESIGN FLOW 480 gpd L.T.A.R. .125 (.117)

Septic Tank: 1000 Gallons; STB 55 Date 3/28/03

Pump Tank: 1000 Gallons; PT 40 Date 5/10/03

Pump Make: Myers Model ME150 Serial No. _____

Nitrification Field: No Fields 3 Square Feet _____ Linear Feet 821

No Lines 14 Trench Width 18" Max Trench Bottom Depth 12-14" Gravel Depth 8"

☑ New System ☐ Repair System Type: I, II, III, ☑ V, VI

System Description: LPP

Repair System Description: LPP

Maintenance Agreement Required: ☑ Yes ☐ No

☑ House/Mod. Home No. Bedrooms 4

☐ Mobile Home No. Bathrooms 3


☐ Business No. Employees _____

☐ Other _____

☐ Slab ☑ Crawl Space ☐ Basement w/plumbing ☐ Basement wo/plumbing

Water Supply: ☐ Individual ☐ Public ☐ Community

Comments:/Conditions: 1"=50'

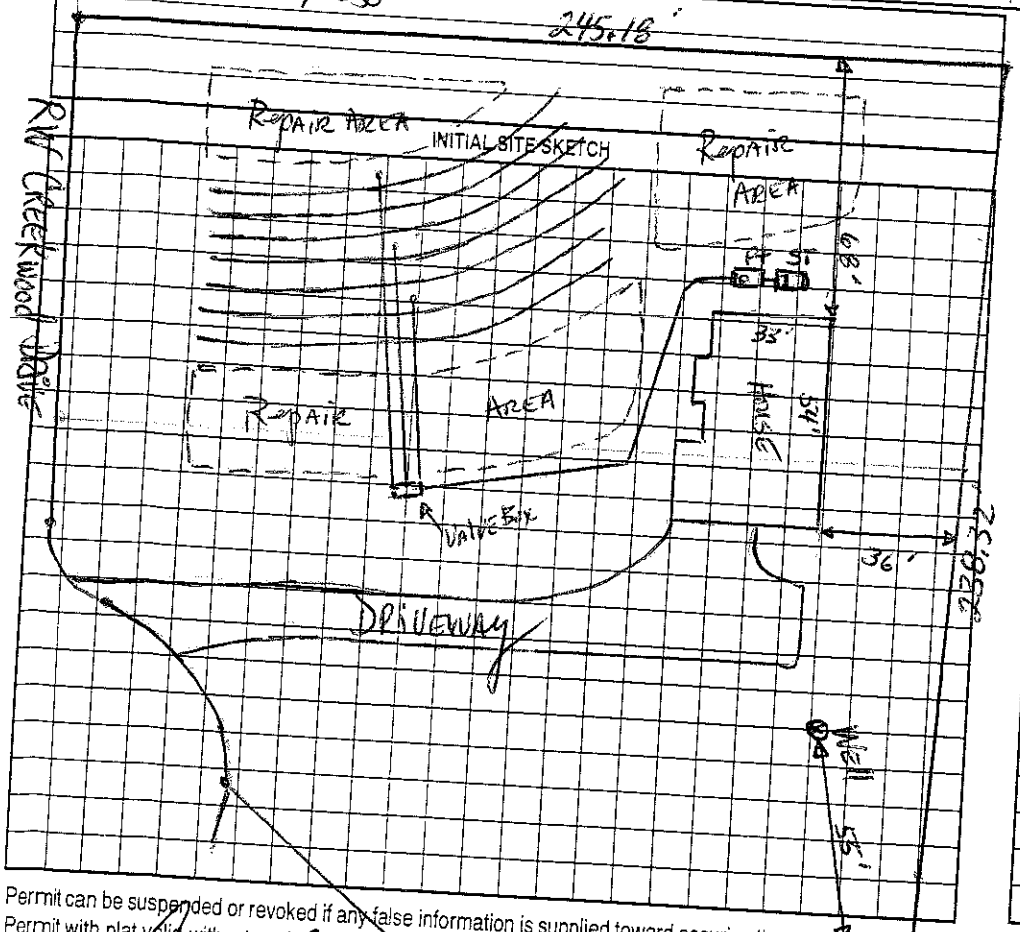

Comments:/Conditions:

SEE LPP plan by S+EC for details.

DOSE NO heavier THAN 306 gal/cycle.

AS BUILT SKETCH

Permit can be suspended or revoked if any false information is supplied toward securing the permit, any unauthorized changes are made to the site/any unauthorized changes are made in the installation of the system. Improvement Permit with plat valid without expiration. Improvement Permit with site plan valid for sixty months. Authorization to Construct is valid for a period equal to that of Improvement Permit – not to exceed sixty months.

Signed: _____

Improvement Permit by: _____ date 6-6-03

Authorization to Construct by: _____ date 6-6-03

Installed by: Corinthian Builders

Operation Permit by: _____ date 10/24/03

Existing System Inspection by: _____ date _____

HEALTH DEPT. COPY: WHITE OWNER COPY (FINAL): YELLOW OWNER COPY (INITIAL): PINK