IREDELL COUNTY HEALTH DEPARTMENT

STATESVILLE 704-878-5305 MOORESVILLE 704-664-5281

IMPROVEMENT PERMIT / AUTHORIZATION TO CONSTRUCT / OPERATION PERMIT / EXISTING SYSTEM INSPECTION

PERMIT# 109471 PIN# 4639-85-2790 DATE June 6, 03

OWNER OR CONTRACTOR Corinthian Development PHONE: Business Home

ADDRESS P.O. Box 990, Denver, N.C. 28037

LOCATION ISOW TR Perth Rd. (N.) TL Fern Hill TL Creekwood on left at end

SUBDIVISION Creekwood BLOCK / SECTION 2 LOT ~~47~~ 29 LOT AREA 1.246 ac SITE CLASS. B per 1957 DESIGN FLOW 480 gpd L.T.A.R. 0125 (.117)

Septic Tank: 1000 Gallons; STB 55 Date 3/28/03

Pump Tank: 1000 Gallons; PT 40 Date 5/10/03

Pump Make: Myers Model ME150 Serial No.

Nitrification Field: No Fields 3 Square Feet Linear Feet 821

No Lines 14 Trench Width 18" Max Trench Bottom Depth 12-14" Gravel Depth 8"

☑ New System ☐ Repair System Type: I, II, III, ⓘ V, VI

System Description: LPP

Repair System Description: LPP

Maintenance Agreement Required: ☑ Yes ☐ No

☑ House/Mod. Home No. Bedrooms 4

☐ Mobile Home No. Bathrooms 3


☐ Business No. Employees

☐ Other

☐ Slab ☑ Crawl Space ☐ Basement w/plumbing ☐ Basement wo/plumbing

Water Supply: ☐ Individual ☐ Public ☐ Community

Comments:/Conditions: 1"=50'

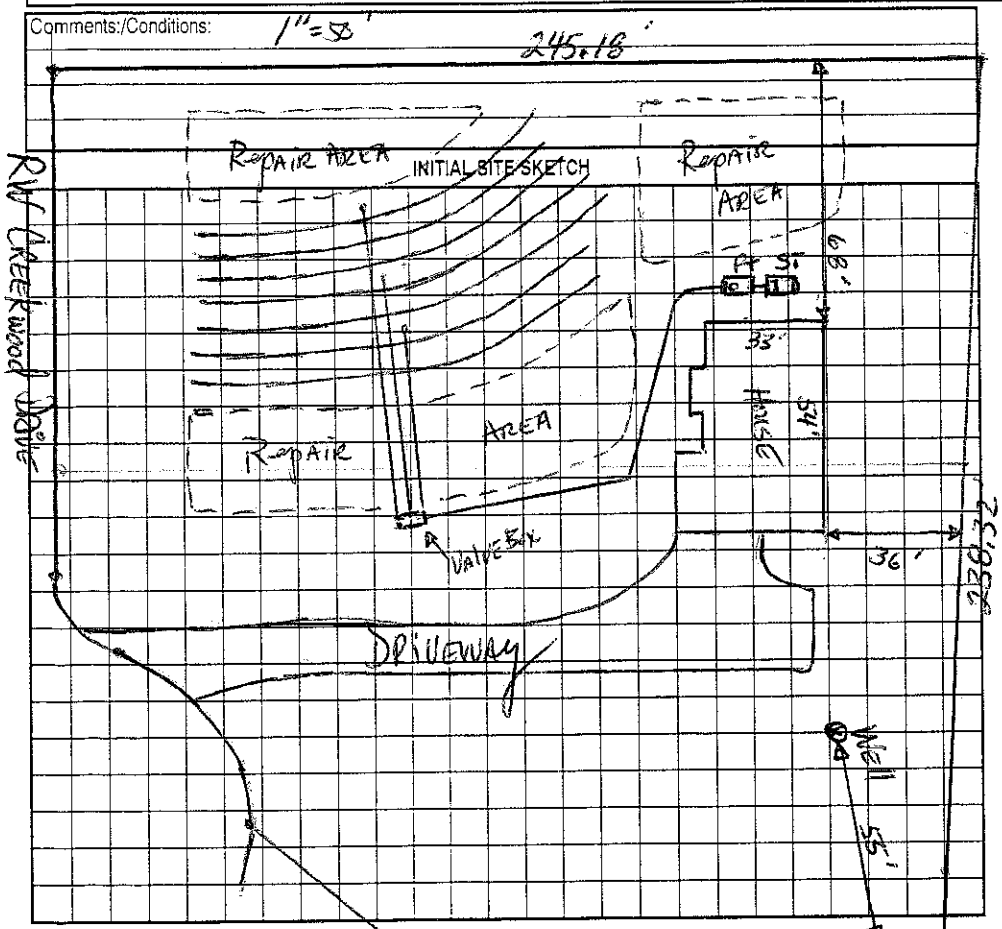

Comments:/Conditions:

SEE LPP plan by S+EC for details.

DOSE NO heavier THAN 306 gal/cycle.

AS BUILT SKETCH

Permit can be suspended or revoked if any false information is supplied toward securing the permit, any unauthorized changes are made to the site/any unauthorized changes are made in the installation of the system. Improvement Permit with plat valid without expiration. Improvement Permit with site plan valid for sixty months. Authorization to Construct is valid for a period equal to that of Improvement Permit – not to exceed sixty months.

Signed: date 6-6-03 Installed by: Corinthian Builders

Improvement Permit by: date 6-6-03 Operation Permit by: LS date 10/24/03

Authorization to Construct by: date 6-6-03 Existing System Inspection by: date

HEALTH DEPT. COPY: WHITE OWNER COPY (FINAL): YELLOW OWNER COPY (INITIAL): PINK