ALP

IREDELL COUNTY HEALTH DEPARTMENT

Statesville Office (704) 878-5305 Mooresville Office (704) 660-3625 PERMIT # 206381

IMPROVEMENT PERMIT / AUTHORIZATION TO CONSTRUCT / OPERATION PERMIT / EXISTING SYSTEM

PIN # 4639955462

APPLICANT: Jason Vieweg APPLICANT ADDRESS: 157 Leaning Tower Dr Mooresville NC 28117

SITE ADDRESS: 157 Leaning Tower Drive PHONE: (218) 230 3986 ALT. PHONE: ~~(218)~~

SITE DIRECTIONS: (157 Leaning Tower Drive) Go 150 W TR on Perth Rd TL onto Bells Crossing take 1st right then 1st left onto Leaning Tower Dr

SUBDIVISION: Bells Crossing SECTION: 2 LOT # 38 LOT AREA: 1 acr DESIGN FLOW: 480 L.T.A.R.: .275

Septic Tank	existing 1000 (gal)	STB		Date			
Pump Tank	(gal)	PT		Date			
Pump Make		Model		Serial #			
# Nitrification Fields	1	# Lines	4 existing	Linear Ft:	444 existing		
Trench Width	36"	Max. Trench Bottom Depth	24"	Gravel Depth	N/A		

☐ New System ☐ Repair ☐ Expansion System Type: I II III IV V VI

System Description: existing 25% reduction

Repair System Description: LPP panel block

Maintenance Agreement Required: ☐ YES ☑ NO

☑ GRAVITY ☐ PRESSURE

☑ Residence No. Bedrooms 4

☐ Business No. Persons

☑ Other Detached No. Employees

☑ Slab Garage ☐ Crawl Space


☐ Basement w/plumbing ☐ Basement w/o plumbing

Water Supply: ☐ Private ☐ Public ☑ Community


Comments / Conditions: Existing system permit for detatched uninhabited garage w/no bedrooms. No increase in total bedrooms over 4 existing or 480 gpd max waste flow. *location of drainlines scaled and drawn from Fast Track info provided by Bateman

Civil Surveying and Final Survey by Bateman Civil Surveying and measurements provided by applicant. Not verified in field.

INITIAL SITE SKETCH

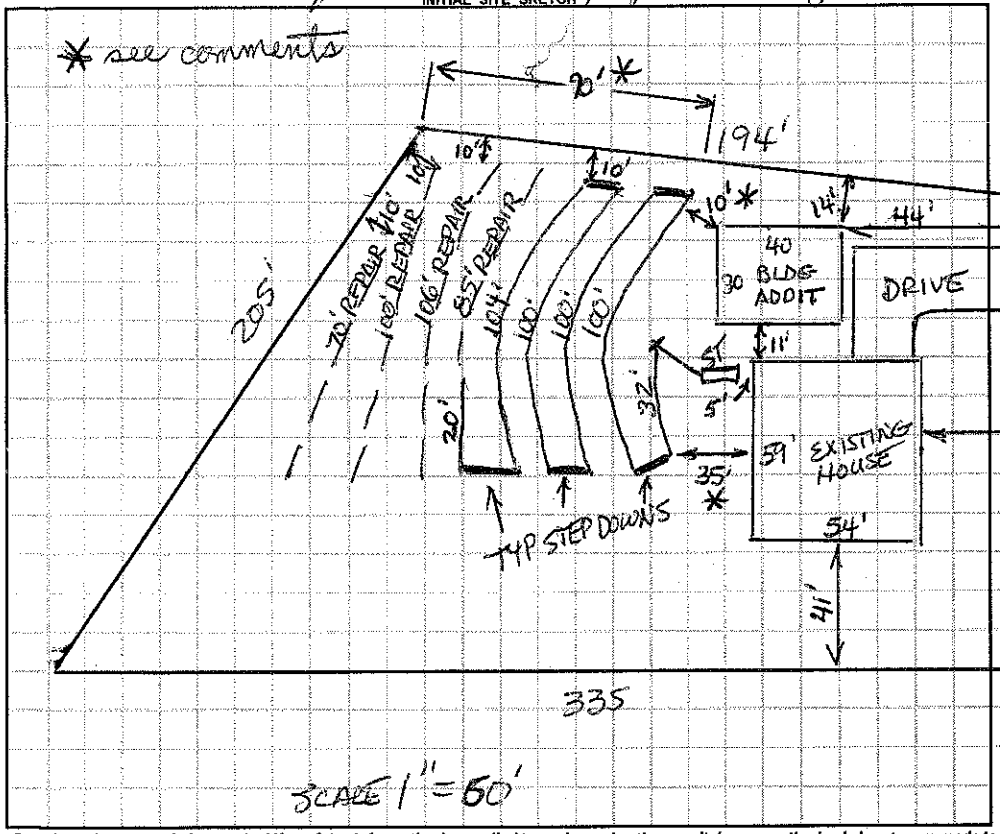

AS BUILT SKETCH

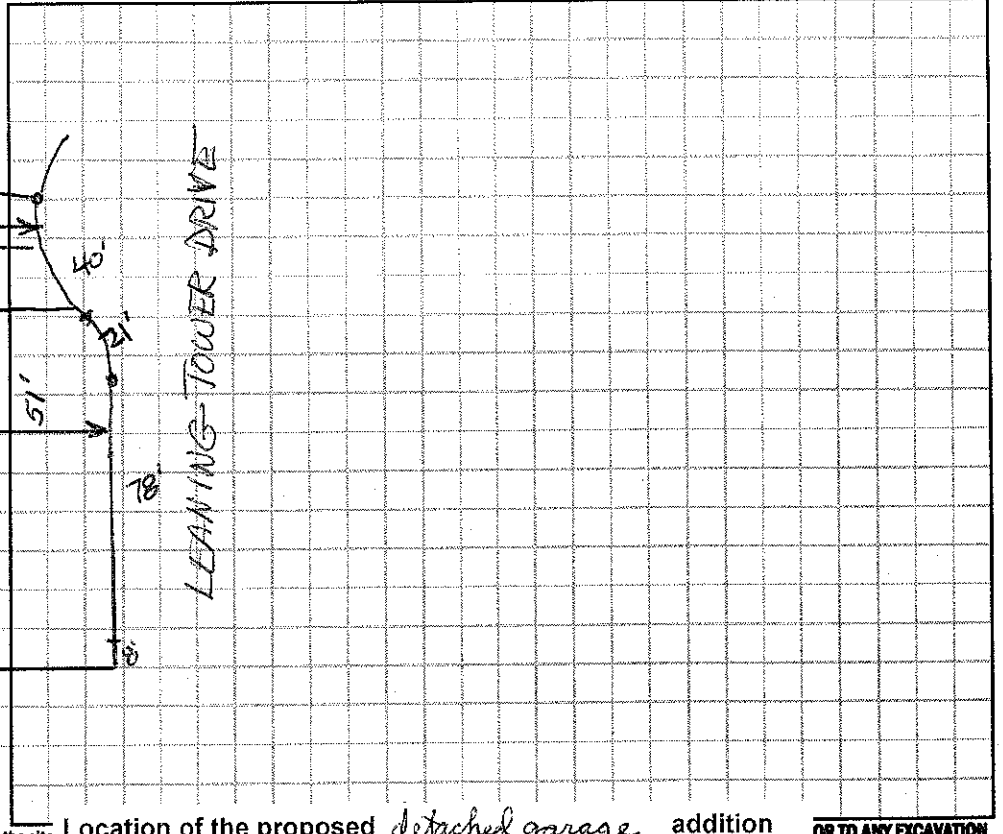

Permit can be suspended or revoked if any false information is supplied toward securing the permit / any unauthorized changes are made to the site

☐ IMPROVEMENT PERMIT *with plat* valid without expiration. ☐ IMPROVEMENT PERMIT *with site plan* valid for 60 mo OR TO ANY EXCAVATION -not to exceed 60 mo.

Location of the proposed detached garage addition does not appear to impact the existing on-site septic system or well.**NOTE:

Owner / Applicant Signature: Date: 10/31/14 Insta

IMPROVEMENT PERMIT by: Date: OPEI

AUTHORIZATION TO CONSTRUCT by: Date: Existing system inspected by: Date:

Richard Farris REHS Date: 10/23/14

ICHD-Environmental Health Division

Health Dept. Copy - WHITE Applicant (Final Approval) - YELLOW Applicant (Conditional Approval) - PINK

IREDELL COUNTY HEALTH DEPARTMENT

Statesville Office (704) 878-5305 Mooresville Office (704) 660-3625 PERMIT # 200908

IMPROVEMENT PERMIT / AUTHORIZATION TO CONSTRUCT / OPERATION PERMIT / EXISTING SYSTEM

PIN # 4639-95-5462 *PART OF*

APPLICANT: Meritage Homes of NC APPLICANT ADDRESS: 17851 N 85th St Scottsdale AZ 85255

SITE ADDRESS: 157 Leaning Tower Dr Mooresville PHONE: 704-944-8903 ALT. PHONE:

SITE DIRECTIONS: Hwy 150 W, TR on Perth Rd, TL on Bells Crossing Dr, TR on N San Agustin Dr, TL on Leaning Tower, Lot on L

SUBDIVISION: Bells Crossing SECTION: LOT # 38 LOT AREA: 1.00ac DESIGN FLOW: 480 gpd L.T.A.R.: 0.275

Septic Tank	1000 (gal)	STB	760	Date	12-20	☑ New System	☐ Repair	☐ Expansion	System Type: I II ◉III IV V VI	☑ Residence	No. Bedrooms 4
Pump Tank	(gal)	PT		Date		System Description:	Gravity 25% Reduction			☐ Business	No. Persons 8
Pump Make		Model		Serial #		Repair System Description:	LP PPBPS			☐ Other	No. Employees
# Nitrification Fields	1	# Lines	4	Linear Ft:	444	Maintenance Agreement Required:	☐ YES	☑ NO		☑ Slab	☐ Crawl Space
Trench Width	36"	Max. Trench Bottom Depth	24"	Gravel Depth	N/A		☑ GRAVITY	☐ PRESSURE		☐ Basement w/plumbing	☐ Basement w/o plumbing

Water Supply: ☐ Private ☐ Public ☑ Community


Comments / Conditions:

INITIAL SITE SKETCH

SEE DESIGN BY BATEMAN CIVIL SURVEY COMPANY

APPROVED BY ICHD

AS BUILT SKETCH

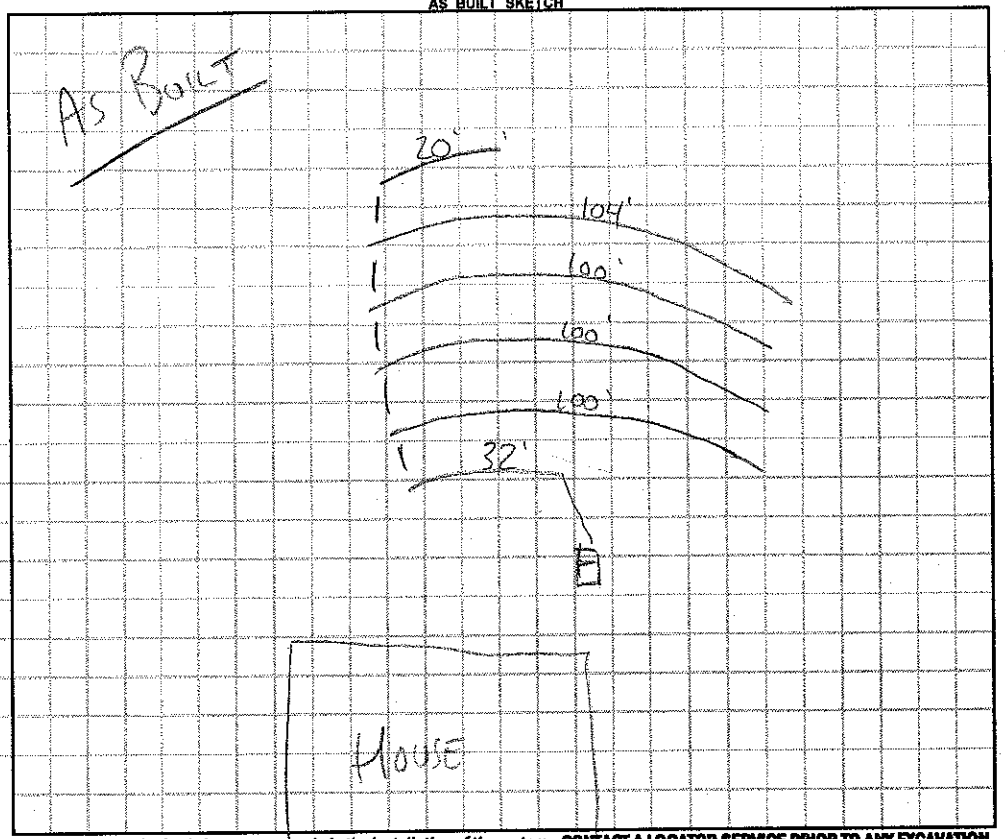

Permit can be suspended or revoked if any false information is supplied toward securing the permit / any unauthorized changes are made to the site / any unauthorized changes are made in the installation of the system. **CONTACT A LOCATOR SERVICE PRIOR TO ANY EXCAVATION**

☐ **IMPROVEMENT PERMIT** *with plat valid without expiration.* ☑ **IMPROVEMENT PERMIT** *with site plan valid for 60 mos.* ☐ **AUTHORIZATION TO CONSTRUCT** *valid for period equal to IMPROVEMENT PERMIT--not to exceed 60 mo.*

Owner / Applicant Signature: [signature] Date: 1-30-14 Installed by: CPC

IMPROVEMENT PERMIT by: [signature] Date: 1-22-14 OPERATION PERMIT by: [signature] APPROVED MAY 23 2014 Date:

AUTHORIZATION TO CONSTRUCT by: [signature] Date: 2/4/13 Existing System Inspected by: Date:

Health Dept. Copy - WHITE Applicant (Final Approval) - YELLOW Applicant (Conditional Approval) - PINK