# IREDELL COUNTY HEALTH DEPARTMENT

STATESVILLE 704-878-5305 MOORESVILLE 704-664-5281

## IMPROVEMENT PERMIT / AUTHORIZATION TO CONSTRUCT / OPERATION PERMIT / EXISTING SYSTEM INSPECTION

PERMIT# 109467 PIN# 4639-85-0633 .25 4639860076 DATE Jan 27, 03

OWNER OR CONTRACTOR Corinthian Development PHONE: Business / Home

ADDRESS P.O. Box 990 Denver, N.C. 28037 / 167 Creekwood.

LOCATION Perth Rd. N. TL Fern Hill TL Creekwood Drive on left near End.

SUBDIVISION Creekwood Village BLOCK / SECTION 2 LOT 25 LOT AREA .592 Ac SITE CLASS PS DESIGN FLOW 360gpd L.T.A.R. .25

Septic Tank: 1000 Gallons; STB 786 Date 2/25/02
Pump Tank: 1000 Gallons; PT 786 Date 2/25/02
Pump Make: Model Serial No.
Nitrification Field: No Fields 1 Square Feet 1080 Linear Feet 360
No Lines 4 @ 90' Trench Width 36" Max Trench Bottom Depth 36" Gravel Depth NA

☑ New System ☐ Repair System Type: I, II, III, IV, V, VI
System Description: P.M. 25% Reduction
Repair System Description: LPPBPS
Maintenance Agreement Required: ☐ Yes ☑ No initially


☑ House/Mod. Home No. Bedrooms 3
☐ Mobile Home No. Bathrooms 2
☐ Business No. Employees
☐ Other
☐ Slab ☑ Crawl Space ☐ Basement w/plumbing ☐ Basement wo/plumbing

Water Supply: ☑ Individual ☐ Public ☐ Community


Comments/Conditions:

Comments/Conditions: EZ FLOW INSTALLED.

1"=50' INITIAL SITE SKETCH

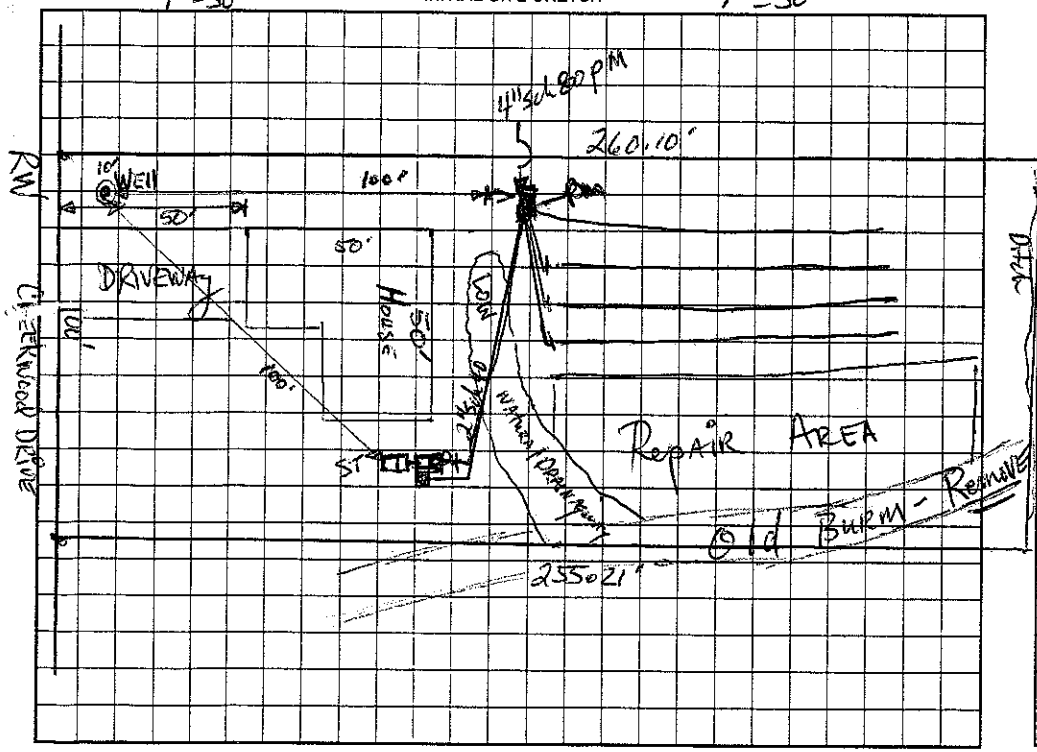


1"=50' AS BUILT SKETCH

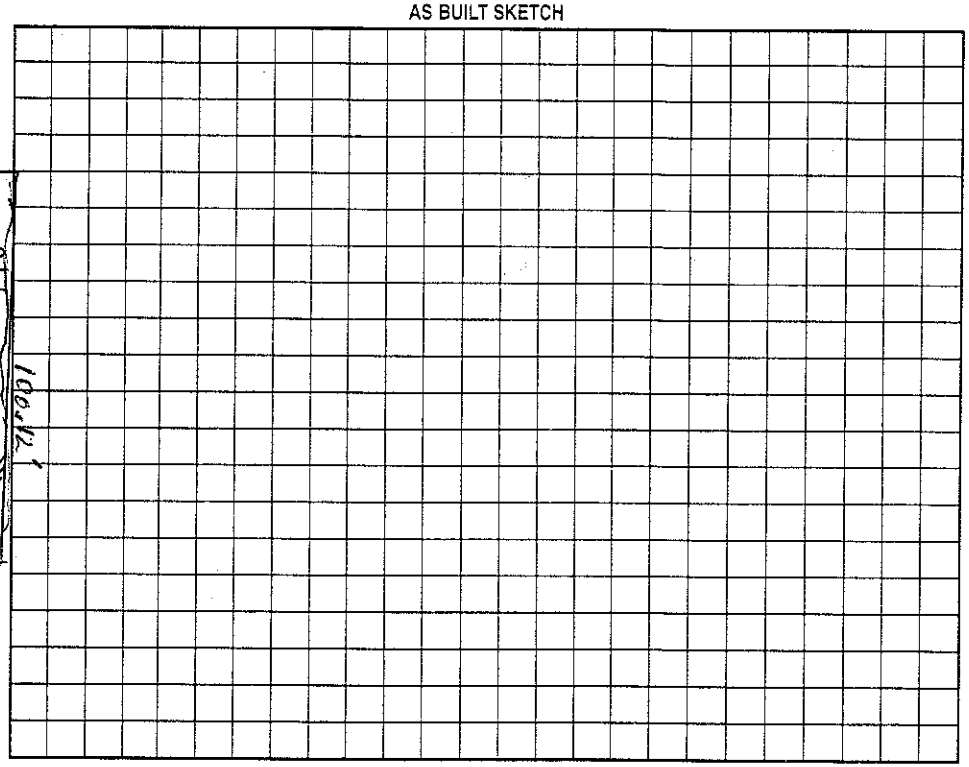


Permit can be suspended or revoked if any false information is supplied toward securing the permit/any unauthorized changes are made to the site/any unauthorized changes are made in the installation of the system. Improvement Permit with plat valid without expiration. Improvement Permit with site plan valid for sixty months. Authorization to Construct is valid for a period equal to that of Improvement Permit – not to exceed sixty months.

Signed: date

Improvement Permit by: date Jan 27 03

Authorization to Construct by: date 2-12-03

Installed by: Corinthian Development

Operation Permit by: Wesley Sparks R.S. date 5/2/03

Existing System Inspection by: date

HEALTH DEPT. COPY: WHITE OWNER COPY (FINAL): YELLOW OWNER COPY (INITIAL): PINK