IREDELL COUNTY HEALTH DEPARTMENT

STATESVILLE 704-878-5305 MOORESVILLE 704-664-5281

IMPROVEMENT PERMIT / AUTHORIZATION TO CONSTRUCT / OPERATION PERMIT / EXISTING SYSTEM INSPECTION

PERMIT# 116738 PIN# ~~4639 96 2769.25~~ 4639-86-5795 DATE 6/28/05

OWNER OR CONTRACTOR Foster Dev. / Mark Doll Enterprises PHONE: Business 704 201-6465 Home

ADDRESS 227 Hideaway Ln. Mooresville NC 28117

LOCATION Perth, TL Honeysuckle 1st, on Lt in Back

SUBDIVISION Honeysuckle Crk BLOCK / SECTION LOT 25 LOT AREA 0.62 ac SITE CLASS. PS DESIGN FLOW 360 L.T.A.R. 0.25

Septic Tank: 1000 Gallons; STB 925 Date 1/11/07
Pump Tank: 1000 Gallons; PT 302 Date 12/1/06
Pump Make: ZOELLER Model N 153B Serial No. 11/06
Nitrification Field: No Fields 1 Square Feet 480 Linear Feet 240
No Lines 4@60' Trench Width 24" Max Trench Bottom Depth 36" Gravel Depth —

☒ New System ☐ Repair System Type: I, II, III, IV, V, VI
System Description: LP Panel Block
Repair System Description: Same
Maintenance Agreement Required: ☒ Yes ☐ No

☒ House/Mod. Home No. Bedrooms 3
☐ Mobile Home No. Bathrooms
☐ Business No. Employees
☐ Other

Water Supply: ☒ Individual ☐ Public ☐ Community

☐ Slab ☒ Crawl Space ☒ Basement w/plumbing ☐ Basement wo/plumbing


Comments:/Conditions:

1"=50'

Comments:/Conditions: Partial

Lines, Tanks, Pressure, WB,

INITIAL SITE SKETCH

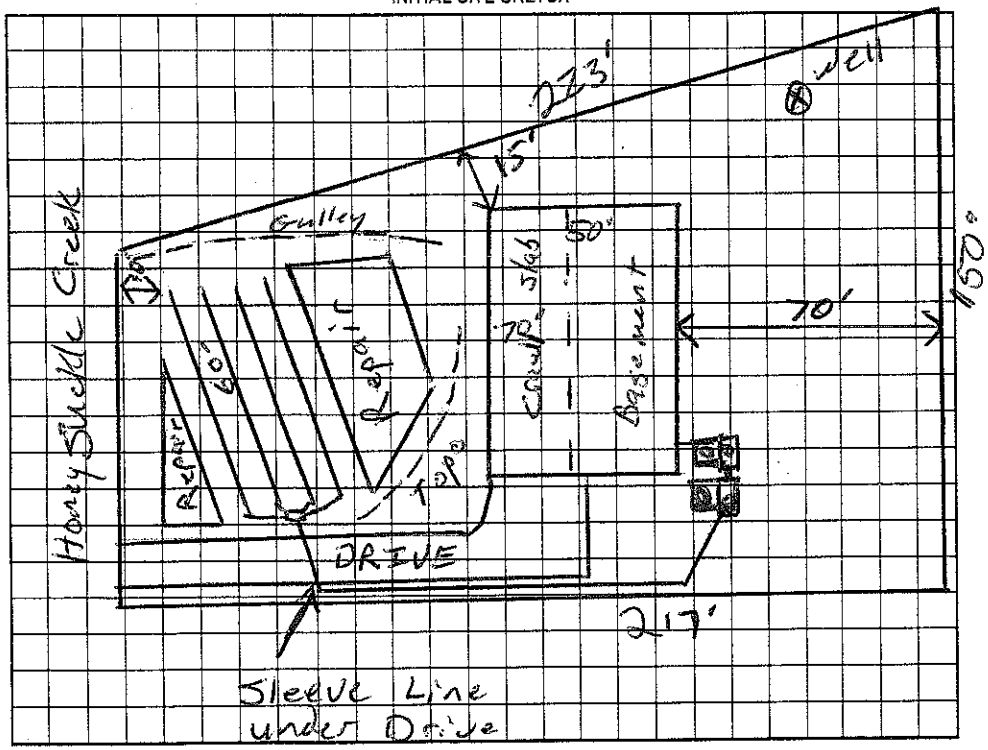

AS BUILT SKETCH

Permit can be suspended or revoked if any false information is supplied toward securing the permit/any unauthorized changes are made to the site/any unauthorized changes are made in the installation of the system. Improvement Permit with plat valid without expiration. Improvement Permit with site plan valid for sixty months. Authorization to Construct is valid for a period equal to that of Improvement Permit – not to exceed sixty months.

Signed: [signature] – mrg date 6-29-05 Installed by: Rowan Septic Tank

Improvement Permit by: [signature] RS date 6/29/05 Operation Permit by: [signature] date 3/28/07

Authorization to Construct by: [signature] RS date 8/1+/06 Existing System Inspection by: date

HEALTH DEPT. COPY: WHITE OWNER COPY (FINAL): YELLOW OWNER COPY (INITIAL): PINK